

STATE OF KANSAS
STATE CORPORATION COMMISSION

Form CP-4

WELL PLUGGING RECORD

Give All Information Completely
Make Required Affidavit
Mail or Deliver Report to:
Conservation Division
State Corporation Commission
211 No. Broadway
Wichita, Kansas

Stafford County. Sec. 11 Twp. 25 Rge. 14 (E) W(W)

Location as "NE/CNW%SW%" or footage from lines SW NE SW

Lease Owner Glickman Oil Company

Lease Name Tanner Well No. 1

Office Address Box 702 S. St. Francis, Wichita, Kansas

Character of Well (completed as Oil, Gas or Dry Hole) D & A

Date well completed June 15 19 66

Application for plugging filed June 15 19 66

Application for plugging approved June 15 19 66


Plugging commenced June 15 19 66

Plugging completed June 15 19 66

Reason for abandonment of well or producing formation

If a producing well is abandoned, date of last production 19

Was permission obtained from the Conservation Division or its agents before plugging was commenced? Yes

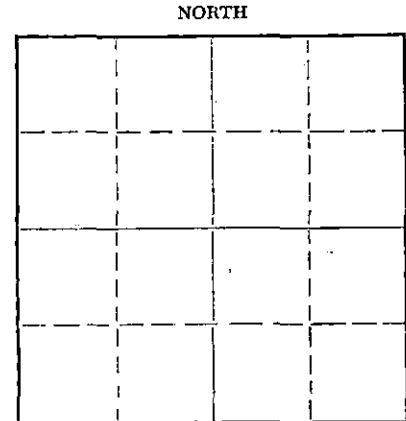

Locate well correctly on above Section Plat

Name of Conservation Agent who supervised plugging of this well Leo Massey

Producing formation Depth to top Bottom Total Depth of Well 3772 Feet

Show depth and thickness of all water, oil and gas formations.

OIL, GAS OR WATER RECORDS

CASING RECORD

FORMATION	CONTENT	FROM	TO	SIZE	PUT IN	PULLED OUT
				8-5/8"	255'	None

Describe in detail the manner in which the well was plugged, indicating where the mud fluid was placed and the method or methods used in introducing it into the hole. If cement or other plugs were used, state the character of same and depth placed, from feet to feet for each plug set.

Mud to 250' Plug at 250' with plug and 1/4 sx hulls, Mud to 40' Bridge with hulls 2 sx dry 10 sx cement, 2 sx rat hole.

RECEIVED
STATE CORPORATION COMMISSION

JUL 8 1966

CONSERVATION DIVISION
Wichita, Kansas

7-8-66

(If additional description is necessary, use BACK of this sheet)

Name of Plugging Contractor Glickman Oil Co.

Address Box 11104, Wichita, Kansas

STATE OF Kansas, COUNTY OF Sedgwick, ss.

Milton Glickman (employee of owner) or (owner or operator) of the above-described well, being first duly sworn on oath, says: That I have knowledge of the facts, statements, and matters herein contained and the log of the above-described well as filed and that the same are true and correct. So help me God.

(Signature) Milton Glickman
Box 11104, Wichita, Kansas
(Address)

SUBSCRIBED AND SWORN TO before me this 25th day of June, 19 66

Lorella Schauf
Lorella Schauf Notary Public.

My commission expires Nov. 19, 1967

