


WELL PLUGGING RECORD

Give All Information Completely
Make Required Affidavit
Mail or Deliver Report to:
Conservation Division
State Corporation Commission
212 No. Market
Wichita, Kansas

NORTH

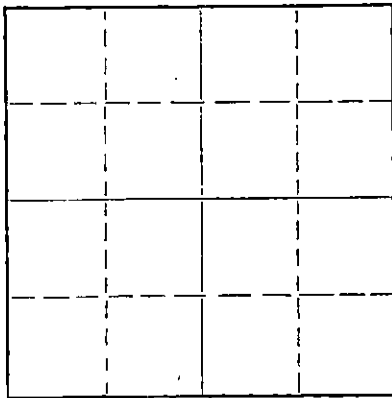

Locate well correctly on above
Section Plat

Edwards County, Sec. 26 Twp. 25s Rge. X(E) 16(W)
Location as "NE/CNW/SW" or footage from lines NE NE NW
Lease Owner Santa-Fe Pipe & Supply, Inc.,
Lease Name Russell Well No. A=1
Office Address Box 562, Great Bend, Kansas
Character of Well (completed as Oil, Gas or Dry Hole) S.W.D.
Date well completed June 9 19 58
Application for plugging filed April 4 19 68
Application for plugging approved April 5 19 68
Plugging commenced April 5 19 68
Plugging completed May 2 19 68
Reason for abandonment of well or producing formation depleted

If a producing well is abandoned, date of last production 19
Was permission obtained from the Conservation Division or its agents before plugging was commenced? yes

Name of Conservation Agent who supervised plugging of this well Mr. R. J. Warren
Producing formation _____ Depth to top _____ Bottom _____ Total Depth of Well 4400 Feet
Show depth and thickness of all water, oil and gas formations.

OIL, GAS OR WATER RECORDS

CASING RECORD

FORMATION	CONTENT	FROM	TO	SIZE	PUT IN	PULLED OUT
				10-3/4"	318'	none
				5 1/2"	4397'	2930.34'

Describe in detail the manner in which the well was plugged, indicating where the mud fluid was placed and the method or methods used in introducing it into the hole. If cement or other plugs were used, state the character of same and depth placed, from _____ feet to _____ feet for each plug set.

4400' - 4368' - plug
4368' - 4340' - sand
4340' - 4300' - 5 sacks cement
4300' - 300' - mud
300' - 290' - rock bridge
290' - 203' - 35 sacks cement
203' - 47' - mud
47' - 37' - rock bridge
37' - base - 15 sacks cement

STATE RECEIVED
CONSERVATION COMMISSION
MAY 27 1968
Wichita, Kansas

(If additional description is necessary, use BACK of this sheet)
Name of Plugging Contractor Santa-Fe Pipe & Supply, Inc.,
Address Box 562, Great Bend, Kansas

STATE OF Kansas, COUNTY OF Barton, ss.
T. L. Nutt (employee of owner) or (owner or operator) of the above-described well, being first duly sworn on oath, says: That I have knowledge of the facts, statements, and matters herein contained and the log of the above-described well as filed and that the same are true and correct. So help me God.

(Signature) T. L. Nutt
Box 562, Great Bend, Kansas
(Address)

SUBSCRIBED AND SWORN TO before me this 25 day of May, 1968.

My commission expires July 31, 1970

Mary M. Guenier
Notary Public.

WELL LOG BUREAU—KANSAS GEOLOGICAL SOCIETY
500 East Murdock, Wichita, Kansas


COPY

Company- NATURAL GAS AND OIL COMPANY
Farm- Russell "A" No. 1

SEC. 26 T. 25 R. 16W
NE NE NW

Total Depth. 4400' PB 4368'
Comm. 5-22-58 Comp. 6-9-58
Shot or Treated.
Contractor. Honaker-Davis Drilling Co.
Issued. 11-15-58

County Edwards KANSAS

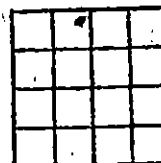

Elevation. 2058 RB

Production. 503 BOPD

CASING:

10 3/4" 318' w/225 sx. cem.
5 1/2" 4397' w/100 sx. cem.

Figures indicate Bottom of Formations.

Top soil and sand	40
sand and gravel	165
blue shale	190
shale	410
sand	455
red bed and shale	1025
anhydrite	1055
shale and shells	2075
lime and shale	2830
shale and lime	2950
lime and shale	4345
lime, shale and chert	4399 RTD
lime	4400
Total Depth	
Total Depth PB	4368

SCHLUMBERGER TOPS

Brown lime	3858
Lansing	3875
Base Kansas City	4160
Base Ft. Scott	4315
Mississippi	4350
Kinderhook Shale	4362
Kinderhook Sand	4370
Viola	4379

Schlumberger and Lane-Wells Gamma Ray logs run.

Perforated 16 holes 4379-83, 10 holes 4373-4376', 500 GA PB 4368, Perf 41 holes 4350-50,500, GA, fraced 7-8-58
State potential- 503 BOPD, thru, 1/2" choke, trace water.

RECEIVED
STATE CORPORATION COMMISSION
APR 5 1968
CONSERVATION DIVISION
Wichita, Kansas