


STATE OF KANSAS
STATE CORPORATION COMMISSION

Form CP-4

Give All Information Completely
Make Required Affidavit
Mail or Deliver Report to:
Conservation Division
State Corporation Commission
212 No. Market
Wichita, Kansas

WELL PLUGGING RECORD

Edwards County. Sec. 26 Twp. 25 Rge. 16 (E) 16 (W)
Location as "NE/CNWSW" or footage from lines SW SW SE
Lease Owner Leben Drilling, Inc.
Lease Name Wilson Well No. 4
Office Address Box 486, Great Bend, Kansas 67530
Character of Well (completed as Oil, Gas or Dry Hole) oil
Date well completed July 16 19 58
Application for plugging filed June 16 19 69
Application for plugging approved 19
Plugging commenced June 26 19 69
Plugging completed July 12 19 69
Reason for abandonment of well or producing formation depleted

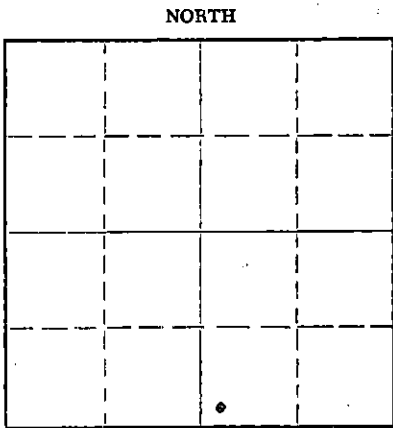

Locate well correctly on above
Section Plat

If a producing well is abandoned, date of last production _____ 19 ____
Was permission obtained from the Conservation Division or its agents before plugging was commenced? yes

Name of Conservation Agent who supervised plugging of this well Ralph Warren
Producing formation _____ Depth to top _____ Bottom _____ Total Depth of Well 4380 Feet
Show depth and thickness of all water, oil and gas formations.

OIL, GAS OR WATER RECORDS

CASING RECORD

FORMATION	CONTENT	FROM	TO	SIZE	PUT IN	PULLED OUT
		0	401'	8 5/8"	401'	none
		0	4374'	5 1/2"	4374'	1829.28

Describe in detail the manner in which the well was plugged, indicating where the mud fluid was placed and the method or methods used in introducing it into the hole. If cement or other plugs were used, state the character of same and depth placed, from _____ feet to _____ feet for each plug set.

Set bridge at 4022' with 10' of sand and 5 sacks of cement.

Squeezed well with 15 sacks of mud and 75 sacks of cement.

RECEIVED
STATE CORPORATION COMMISSION
JUL 18 1969
CONSERVATION DIVISION
Wichita, Kansas

(If additional description is necessary, use BACK of this sheet)
Name of Plugging Contractor PIPE PULLERS, INC.
Address Box 486, Ellinwood, Kansas

STATE OF Kansas, COUNTY OF Barton, ss.
Evelyn Roth (employee of owner) or (owner or operator) of the above-described well, being first duly sworn on oath, says: That I have knowledge of the facts, statements, and matters herein contained and the log of the above-described well as filed and that the same are true and correct. So help me God.

(Signature) Evelyn Roth
Ellinwood, Kansas (Address)

SUBSCRIBED AND SWORN TO before me this 17th day of July, 19 69

My commission expires Feb. 10, 1971

George A. Meyer
Notary Public.

COPY


WELL LOG BUREAU—KANSAS GEOLOGICAL SOCIETY
508 East Murdock, Wichita, Kansas

Company. L. C. SMITHERMAN OIL
Farm. Wilson No. 4

SEC. 26 T. 25 R. 16W
SW SW SE

Total Depth. 4380'
Comm. 6-29-58 Comp. 7-16-58
Shot or Treated.
Contractor. L. C. Smitherman Drilg.
Issued. 3-7-59

County Edwards
KANSAS

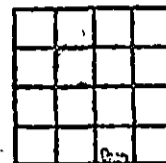

Elevation. 2057' DF

Production. 70 BOPD

CASINO:

8 5/8" 401' cem w/250 ex.
5" 4374' cem w/100 ex.

Figures indicate Bottom of Formations.

sand	121
sand & gravel	211
shells & shale	397
red bed & shale	1040
Anhydrite	1055
shale & shells	1315
shale & sand	1360
shale & shells	1500
shale	1720
shale & shells	1934
shale & lime	2320
lime	2625
lime & shale	2660
shale w/lime streaks	2700
lime w/shale streaks	2910
lime & shale	3395
lime w/shale streaks	3520
lime & shale	3665
lime	3774
lime & shale	3867
lime	3870
lime & shale	3921
lime	4152
shale & lime	4228
lime	4278
lime & shale	4380
Total Depth	

TOPS: SCOUT	
Heebner	3725
Brown Lime	3868
Lansing	3886
Cherokee	4346
Cherty Conglomerate	4365

RECEIVED
STATE CORPORATION COMMISSION
JUN 18 1969
CONSERVATION DIVISION
Wichita, Kansas