


STATE OF KANSAS
STATE CORPORATION COMMISSION

Give All Information Completely
Make Required Affidavit
Mail or Deliver Report to:
Conservation Division
State Corporation Commission
212 No. Market
Wichita, Kansas

WELL PLUGGING RECORD

NORTH

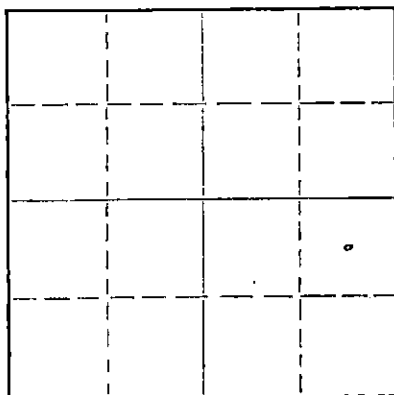

Locate well correctly on above
Section Plat

Edwards County, Sec. 26 Twp. 25S Rge. 16 (E) 16 (W)
Location as "NE/CNW/SE" or footage from lines C NE SE
Lease Owner: Leben Drilling Inc.
Lease Name: Wilson Well No. 5
Office Address: Box 486, Great Bend, Kansas
Character of Well (completed as Oil, Gas or Dry Hole) oil
Date well completed _____ 19____
Application for plugging filed March 28 1968
Application for plugging approved _____ 19____
Plugging commenced March 29 1968
Plugging completed April 2 1968
Reason for abandonment of well or producing formation depleted

If a producing well is abandoned, date of last production _____ 19____
Was permission obtained from the Conservation Division or its agents before plugging was commenced? yes

Name of Conservation Agent who supervised plugging of this well Archie Elving
Producing formation _____ Depth to top _____ Bottom _____ Total Depth of Well 4460 Feet
Show depth and thickness of all water, oil and gas formations.

OIL, GAS OR WATER RECORDS

CASING RECORD

FORMATION	CONTENT	FROM	TO	SIZE	PUT IN	PULLED OUT
		0	400'	8 5/8"	400'	none
		0	4460'	5 1/2"	4460'	3339.81

Describe in detail the manner in which the well was plugged, indicating where the mud fluid was placed and the method or methods used in introducing it into the hole. If cement or other plugs were used, state the character of same and depth placed, from _____ feet to _____ feet for each plug set.

Sand back to 4390' and dump 5 sacks cement.

Set 10' rock bridge at 300' and dump 25 sacks cement. Fill hole with mud to 40', set 10' rock bridge and cap hole with 10 sacks cement.

RECEIVED
STATE CORPORATION COMMISSION
APR 11 1968
CONSERVATION DIVISION
Wichita, Kansas

(If additional description is necessary, use BACK of this sheet)
Name of Plugging Contractor Pipe Pullers, Inc.
Address Box 486, Ellinwood, Kansas

STATE OF Kansas, COUNTY OF Barton, ss.
Evelyn Roth (employee of owner) or (~~owner or operator~~) of the above-described well, being first duly sworn on oath, says: That I have knowledge of the facts, statements, and matters herein contained and the log of the above-described well as filed and that the same are true and correct. So help me God.

(Signature) Evelyn Roth
Ellinwood, Kansas (Address)

SUBSCRIBED AND SWORN TO before me this 10th day of April, 1968
Seared Meyer Notary Public.

My commission expires Feb. 10, 1971

DRILLER'S LOG

COMPANY: R. T. Leeper
 CONTRACTOR: L. C. Smitherman Drilling
 FARM: WILSON #5
 LOCATION: C NE SE SECTION 26-25S-16W
 EDWARDS COUNTY, KANSAS
 COMMENCED: 1-15-59
 COMPLETED: 5-1-59

0	40	Sand, Shale
40	250	Sand
250	398	Shale
398	670	Shale, Sand
670	1080	Redbed, Shale
1080	1100	Anhydrite
1100	1725	Shale, Shells
1725	2460	Lime, Shale
2460	2950	Lime
2950	3235	Lime, Shale
3235	3335	Lime
3335	3570	Lime, Shale
3570	3840	Lime
3840	3913	Lime, Shale
3913	4383	Lime
4383	4403	Lime, Chert
4403	4460	Lime
	<u>4460</u>	<u>RTD - Set 5½" Casing</u>

RECEIVED
 STATE CORPORATION COMMISSION
 APR 2 1968
 CONSERVATION DIVISION
 Wichita, Kansas

Set 8 5/8" surface casing @ 342' cemented with 275 sacks of Common

I, James L. Wright, do hereby certify that the above and foregoing is a true and correct copy of the log of the Wilson #5 Well, located C. NE SE of Section 26, Township 25 South, Range 16 West, of Edwards County, Kansas, as reflected by the records of L. C. Smitherman Drilling.

James L. Wright

James L. Wright

STATE OF KANSAS)
) SS
 COUNTY OF BARTON)

Subscribed and sworn to and before me, a Notary Public, in and for Barton County, Kansas, this 1st day of April, 1968.

Ulanda Nichols

Ulanda Nichols

My Commission Expires:
 April 1, 1971