

STATE OF KANSAS
STATE CORPORATION COMMISSION


Form CP-4

WELL PLUGGING RECORD

Give All Information Completely
Make Required Affidavit
Mail or Deliver Report to:
Conservation Division
State Corporation Commission
212 No. Market
Wichita, Kansas

Edwards County, Sec. 25 Twp. 25S Rge. (E) 16W(W)
Location as "NE/CNW/SE/SW" or footage from lines C SE/4
Lease Owner O.F.S., Inc.
Lease Name F. W. Lamb Well No. 5
Office Address 630 Founders Life Tower, Okla. City, Okla.
Character of Well (completed as Oil, Gas or Dry Hole) Dry Hole
Date well completed November 5, 19 72
Application for plugging filed 19
Application for plugging approved 19
Plugging commenced November 5, 19 72
Plugging completed November 5, 19 72
Reason for abandonment of well or producing formation Dry Hole

NORTH

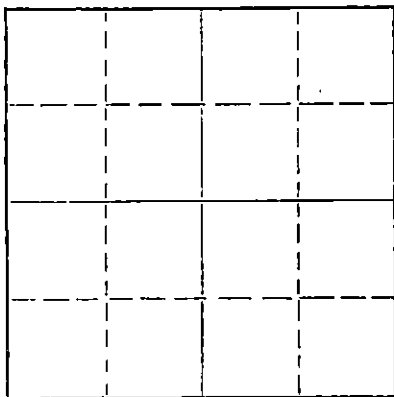

Locate well correctly on above
Section Plat

If a producing well is abandoned, date of last production 19
Was permission obtained from the Conservation Division or its agents before plugging was com-
menced? Yes (G. Russell Biberstein of Attica)

Name of Conservation Agent who supervised plugging of this well
Producing formation Depth to top Bottom Total Depth of Well 4342 Feet
Show depth and thickness of all water, oil and gas formations.

OIL, GAS OR WATER RECORDS

CASING RECORD

FORMATION	CONTENT	FROM	TO	SIZE	PUT IN	PULLED OUT
	Surface	0	362'	8-5/8"	362'	None
	Casing					

Describe in detail the manner in which the well was plugged, indicating where the mud fluid was placed and the method or methods used in introducing it into the hole. If cement or other plugs were used, state the character of same and depth placed, from feet to feet for each plug set.

Heavy Mud from Total Depth to 600 Feet,
Plug and 45 sax Cement; Mud to 300 Feet,
Plug and 35 sax Cement; Mud to 40 Feet,
1/2 sax Halls, Plug and 15 sax Cement to
Base of Cellar; 2 sax in Rat Hole.
Job completed @ 11:00 A.M.


RECEIVED
STATE CORPORATION COMMISSION
NOV 9 1972
CONSERVATION DIVISION
Wichita, Kansas

(If additional description is necessary, use BACK of this sheet)
Name of Plugging Contractor Globe Oilwell Cementing, Inc.
Address Box 628, Great Bend, Kansas 67530

STATE OF KANSAS, COUNTY OF SEDGWICK, ss.
Clarence Michael of Sage Drilling Co. being first duly sworn on oath, says: That I have knowledge of the facts, statements, and matters herein contained and the log of the above described well as filed and that the same are true and correct. So help me God.

(Signature) Clarence Michael
500 Bitting Bldg., Wichita, Kansas
(Address)

Subscribed and Sworn to before me this 8th day of November, 19 72.
Louise K. Whitted
Louise K. Whitted - Notary Public.

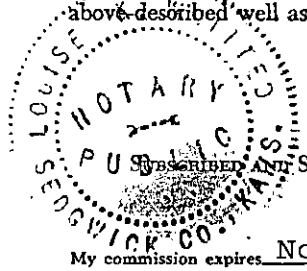

DRILLERS LOG

F. W. LAMB NO. 5

CASING RECORD: OPERATOR: O.F.S., Inc. DESCRIPTION:
8-5/8" @ 362' CONTRACTOR: Sage Drilling Co. C SE/4
w/250 sax cement COMMENCED: October 25, 1972 Sec. 25-25S-16W
Edwards Co., Kansas
TOTAL DEPTH: COMPLETED: November 5, 1972 ELEVATION: 2047KB
4342'

<u>FORMATION</u>	<u>FROM</u>	<u>TO</u>	<u>REMARKS</u>
Sand & Shale	0	366	
Shale	366	1990	
Shale & Sand	1990	2080	
Shale & Lime	2080	2255	
Lime & Shale	2255	2388	
Shale w/Lime Streaks	2388	2408	
Lime & Shale	2408	2675	
Shale & Lime	2675	2736	
Lime & Shale	2736	2856	
Shale & Lime	2856	3065	
Lime & Shale	3065	3765	
Lime	3765	4342	D&A

RECEIVED
STATE CORPORATION COMMISSION
NOV 9 1977
CONSERVATION DIVISION
Wichita, Kansas

I certify that this is a true and correct copy of the above log to the best of my knowledge.

SAGE DRILLING CO., INC.

BY Clarence Michael
Clarence Michael



Subscribed and sworn to before me this 8th day of November, 1972.

Louise K. Whitted
Louise K. Whitted, Notary Public

My commission expires:
November 26, 1974.