


STATE OF KANSAS
STATE CORPORATION COMMISSION

WELL PLUGGING RECORD

Give All Information Completely
Make Required Affidavit
Mail or Deliver Report to
Conservation Division
State Corporation Comm.
245 North Water
Wichita, KS 67202

Edwards County. Sec. 25 Twp. 25S Rge. 16W E/W
Location as "NE/CNW $\frac{1}{4}$ SW $\frac{1}{4}$ " or footage from lines _____
SW SW NE

Lease Owner D. R. Lauck Oil Company, Inc.
Lease Name R. & K. Grizzell Well No. 1
Office Address 221 S. Broadway, Suite 400, Wichita, KS 67202
Character of Well (Completed as Oil, Gas or Dry Hole) _____

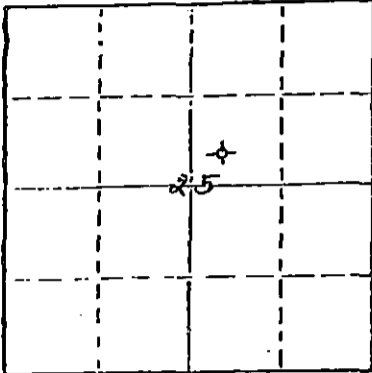

Locate well correctly on above
Section Plat

Dry Hole
Date Well completed September 27, 19 81
Application for plugging filed September 27, 19 81
Application for plugging approved September 27, 19 81
Plugging commenced September 27, 19 81
Plugging completed September 27, 19 81
Reason for abandonment of well or producing formation _____

Dry hole.
If a producing well is abandoned, date of last production _____
19 _____

Was permission obtained from the Conservation Division or
its agents before plugging was commenced? Yes

Name of Conservation Agent who supervised plugging of this well Paul Luthi
Producing formation _____ Depth to top _____ Bottom _____ Total Depth of Well 4409'
Show depth and thickness of all water, oil and gas formations.

OIL, GAS OR WATER RECORDS

CASING RECORD

FORMATION	CONTENT	FROM	TO	SIZE	PUT IN	PULLED OUT
		0'	353'	8-5/8"	346.87'	None

Describe in detail the manner in which the well was plugged, indicating where the mud fluid
was placed and the method or methods used in introducing it into the hold. If cement or other
plugs were used, state the character of same and depth placed, from _____ feet to
_____ feet for each plug set.

Plugged with 50 sacks cement at 700';
rubber plug, 1 sack hulls, and 35 sacks
cement at 325'; bridge plug and 10 sacks
cement at 40'; and 10 sacks cement in
rat hole.

(If additional description is necessary, use BACK of this sheet)

Name of Plugging Contractor Allied Cementing Co.


STATE OF KANSAS COUNTY OF SEDGWICK, ss.

John D. Knightley (employee of owner) or (owner or operator)
of the above-described well, being first duly sworn on oath, says: That I have knowledge of
the facts, statements, and matters herein contained and the log of the above-described well
as filed and that the same are true and correct. So help me God.

(Signature)

[Signature]
221 S. Broadway, Suite 400, Wichita, KS 67202
(Address)

SUBSCRIBED AND SWORN TO before me this 5th day of October, 19 81

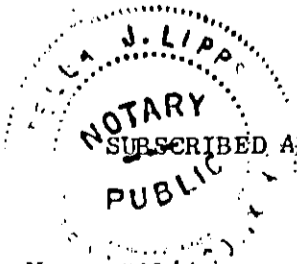

Stella J. Lipps
Notary Public.

My commission expires March 12, 1983

10-7-1981

RECEIVED

STATE CORPORATION COMMISSION

OCT 7 1981

CONSERVATION DIVISION
Wichita Kansas

D. R. Lauck Oil Company, Inc. - R. & K. Grizzell #1
221 S. Broadway, Suite 400 SW SW NE Sec. 25-25S-16W
Wichita, Kansas 67202 Edwards County, Kansas

Contractor: D. R. Lauck Oil Company, Inc.
221 S. Broadway, Suite 400
Wichita, Kansas 67202

Commenced: September 17, 1981
Completed: September 27, 1981

Drillers Log

Sand	220
Clay	390
Red Bed	1035
Anhydrite	1270
Shale & Shells	2000
Shale	2340
Shale & Lime	3110
Lime & Shale	3250
Shale & Lime	4078
Lime	4275
Lime & Shale	4325
Lime	4370
Shale	4385
Lime	4409 RTD