


STATE OF KANSAS
STATE CORPORATION COMMISSION

WELL PLUGGING RECORD

Give All Information Completely
Make Required Affidavit
Mail or Deliver Report to:
Conservation Division
State Corporation Commission
212 No. Market
Wichita, Kansas

Edwards County, Sec. 24 Twp. 25 Rge. 16 (E) W (W)
Location as "NE/CNWxSWx" or footage from lines C-NW/NE

Lease Owner Armstrong-Jackman
Lease Name Lloyd Miller Well No. 1
Office Address 655 Fourth Natl. Bank Wichita
Character of Well (completed as Oil, Gas or Dry Hole) Dry
Date well completed _____ 19____
Application for plugging filed _____ Dec. 9, 1968
Application for plugging approved _____ Dec. 14, 1968
Plugging commenced _____ Dec. 10, 1968
Plugging completed _____ Dec. 16, 1968
Reason for abandonment of well or producing formation _____

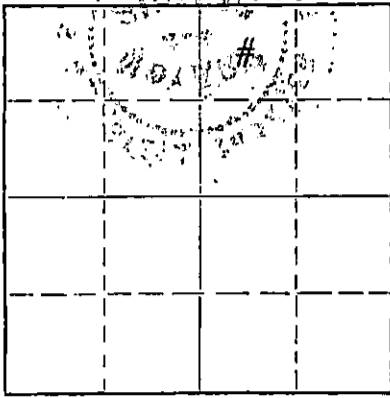

Locate well correctly on above
Section Plat

If a producing well is abandoned, date of last production _____ 19____
Was permission obtained from the Conservation Division or its agents before plugging was commenced? Yes

Name of Conservation Agent who supervised plugging of this well Ralph Warren
Producing formation _____ Depth to top _____ Bottom _____ Total Depth of Well _____ Feet
Show depth and thickness of all water, oil and gas formations.

OIL, GAS OR WATER RECORDS

CASING RECORD

FORMATION	CONTENT	FROM	TO	SIZE	PUT IN	PULLED OUT
				8 5/8	350'	None
				5 1/2	4319'	2710'

Describe in detail the manner in which the well was plugged, indicating where the mud fluid was placed and the method or methods used in introducing it into the hole. If cement or other plugs were used, state the character of same and depth placed, from _____ feet to _____ feet for each plug set.

Plugged back with sand from 4320' to 4280'. Mixed and dumped 5 sx. of cement from 4280' to 4240'. Pulled casing. Mixed and pumped in 10 sx. of gel. Mixed and pumped in 75 sx. of cement from 505' to 280'. Mixed and pumped in 5 sx. of gel from 280' to 30'. Mixed and pumped in 10 sx. of cement from 30' to base of the cellar.

RECEIVED
STATE CORPORATION COMMISSION
JAN 17 1969
CONSERVATION DIVISION
Wichita, Kansas


(If additional description is necessary, use BACK of this sheet)

Name of Plugging Contractor Russ Casing Pulling Inc.
Address Box 1082 Great Bend, Ks.

STATE OF Kansas, COUNTY OF Sedgwick, ss.

Dwight Wickman Jr., one of the operators (employee of owner) or (owner or operator) of the above-described well, being first duly sworn on oath, says: That I have knowledge of the facts, statements, and matters herein contained and the log of the above-described well as filed and that the same are true and correct. So help me God.

(Signature) Dwight Wickman Jr.
Armstrong and Jackman
655 4th Natl. Bldg., Wichita, Kansas
(Address)

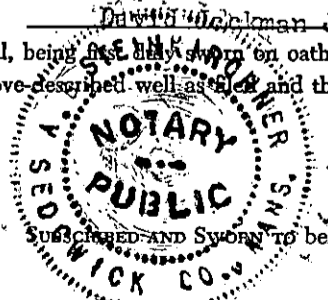

Subscribed and sworn to before me this 10th day of January, 1969

My commission expires

11/18/70

A.B. Steinkirchner

Notary Public.

DRILLERS LOG

MILLER NO. 1

CASING RECORD: OPERATOR: Armstrong & Jackman DESCRIPTION:
8-5/8" @ 350' CONTRACTOR: Sage Drilling Co. C NW NE
w/250 sax cement COMMENCED: September 12, 1968 Sec. 24-25S-16W
Edwards County, Kansas
TOTAL DEPTH: COMPLETED: September 19, 1968 ELEVATION: 2056KB
4365'

<u>FORMATION</u>	<u>FROM</u>	<u>TO</u>	<u>REMARKS</u>
Sand	0	45	
Sand & Shale	45	350	
Shale, Shells & Red Bed	350	1041	
Anhydrite	1041	1150	
Shale, Shells, Red Bed & Lime	1150	2016	
Lime and Shale	2016	2290	
Sandy Lime & Shale	2290	2360	
Lime & Shale	2360	3061	
Lime	3061	3375	
Lime & Shale	3375	3558	
Shale & Lime	3558	3860	
Lime & Shale	3860	3978	
Lime	3978	4130	
Lime & Shale	4130	4220	
Lime	4220	4348	
Shale	4348	4365	5 1/2" @ 4362' W/125 sax

RECEIVED
STATE CORPORATION COMMISSION
DEC 12 1968
CONSERVATION DIVISION
Wichita, Kansas

I certify that this is a true and correct copy of the above log to the best of my knowledge.

SAGE DRILLING CO., INC.

By Wayne W. Kahmeyer
Wayne W. Kahmeyer



Subscribed and sworn to before me this 23rd day of September, 1968.

Louise K. Whitted
Louise K. Whitted, Notary Public

My commission expires:
November 26, 1970.