

R


STATE OF KANSAS
STATE CORPORATION COMMISSION

WELL PLUGGING RECORD

Give All Information Completely
Make Required Affidavit
Mail or Deliver Report to:
Conservation Division
State Corporation Commission
800 Bittling Building
Wichita, Kansas

Edwards County. Sec. 24 Twp. 25 Rge. 16 ~~(E) W~~ (W)
Location as "NE/CNW%SW%" or footage from lines SE NW SE
Lease Owner Colorado Oil and Gas Corporation
Lease Name KEARNS Well No. 1
Office Address P. O. Box 1030, Wichita, Kansas
Character of Well (completed as Oil, Gas or Dry Hole) Dry Hole
Date well completed July 19 1959
Application for plugging filed October 12 1959
Application for plugging approved October 13 1959
Plugging commenced October 26 1959
Plugging completed November 5 1959
Reason for abandonment of well or producing formation _____

NORTH

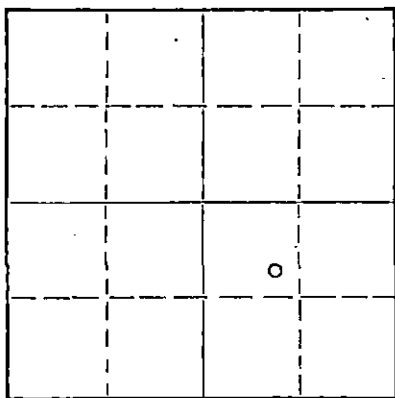

Locate well correctly on above
Section Plat

If a producing well is abandoned, date of last production _____ 19____
Was permission obtained from the Conservation Division or its agents before plugging was commenced? Yes

Name of Conservation Agent who supervised plugging of this well Frank Broadfoot
Producing formation _____ Depth to top _____ Bottom _____ Total Depth of Well 4408 Feet
Show depth and thickness of all water, oil and gas formations. 4308 FBTD

OIL, GAS OR WATER RECORDS

CASING RECORD

FORMATION	CONTENT	FROM	TO	SIZE	PUT IN	PULLED OUT
				8-5/8"	339'	None
				5-1/2"	4408'	3296'

Describe in detail the manner in which the well was plugged, indicating where the mud fluid was placed and the method or methods used in introducing it into the hole. If cement or other plugs were used, state the character of same and depth placed, from _____ feet to _____ feet for each plug set.

Checked the hole to 4308' and found it open. Filled with sand to 4280' and dumped 5 sacks of cement with bailer. Pulled 5-1/2" casing and squeezed well with 30 sacks mud and 75 sacks of cement. Cement filled to 20', mudded the hole to 15' and ran 5 sacks of cement to base of cellar.

PLUGGING COMPLETED

RECEIVED
STATE CORPORATION COMMISSION

NOV 12 1959

CONSERVATION DIVISION
Wichita, Kansas

11-12-1959

(If additional description is necessary, use BACK of this sheet)
Name of Plugging Contractor Knight Casing Pulling Company
Address Chase, Kansas

STATE OF Kansas, COUNTY OF Sedgwick, ss.
Bill K. Henrichs (employee of owner) or (owner or operator) of the above-described well, being first duly sworn on oath, says: That I have knowledge of the facts, statements, and matters herein contained and the log of the above-described well as filed and that the same are true and correct. So help me God.

(Signature) Bill K. Henrichs
Bill K. Henrichs
Box 1030, Wichita, Kansas
(Address)

SUBSCRIBED AND SWORN TO before me this 11th day of November, 1959

Helen L. Martin
Helen L. Martin
Notary Public.

My commission expires August 19, 1963



~~CURRENT-DRILLING CO., INC.~~


WICHITA, KANSAS

DRILLER'S WELL LOG

NEARNS #1
SE NW SE Sec. 24-25-16
EDWARDS COUNTY, KANSAS
COMMENCED 3-29-58
COMPLETED 4-14-58

DEPTH		FORMATION	REMARKS
FROM	TO		
0	190	SAND	RAN 336.82' OF 8-5/8" CASING, CEMENTED @ 333' WITH 200 BAGS CEMENT.
190	333	SHALE	
333	575	RED BED & SHALE	RAN 4409' OF 5-1/2" CASING, CEMENTED @ 4408' WITH 125 BAGS CEMENT.
575	910	SAND & SHALE	
910	1040	SHALE	
1040	1050	ANHYDRITE	
1050	1405	SHALE	
1405	1690	SHALE, SNELLS & SALT	
1690	2155	SHALE & SNELLS	
2155	2915	SHALE & LIME	
2915	3000	SHALE, SNELLS & SAND	
3000	3040	SHALE & SAND	
3040	3135	SHALE, SAND & CHALK	
3135	3610	LIME & SHALE	
3610	3725	LIME	
3725	3920	LIME & SHALE	
3920	4288	LIME	
4288	4324	CONGLOMERATE	
4324	4359	CHERTY CONGLOMERATE	
4359	4471	CHERT & SHALE	
4471		TD	

I, E. E. HALL, CERTIFY THIS TO BE A TRUE AND CORRECT COPY OF THE DRILLER'S WELL LOG FOR THE NEARNS #1 WELL.



E. E. HALL

STATE OF KANSAS }
COUNTY OF SEDGWICK } SS:

BEFORE ME, THE UNDERSIGNED, A NOTARY PUBLIC, WITHIN AND FOR SAID COUNTY AND STATE, ON THIS 15TH DAY OF APRIL, 1958 PERSONALLY APPEARED E. E. HALL TO ME PERSONALLY KNOWN TO BE THE IDENTICAL PERSON WHO EXECUTED THE WITHIN AND FOREGOING INSTRUMENT AND ACKNOWLEDGED TO ME THAT HE EXECUTED THE SAME AS HIS FREE AND VOLUNTARY ACT AND DEED FOR THE USES AND PURPOSES THEREIN SET FORTH.

IN WITNESS WHEREOF, I HAVE HEREBY SET MY HAND AND OFFICIAL SEAL THE DAY AND YEAR LAST ABOVE WRITTEN.



NOTARY PUBLIC

MY COMMISSION EXPIRES NOVEMBER 9, 1959.