

This form shall be filed in duplicate with the Kansas Corporation Commission, 200 Colorado Derby Building, Wichita, Kansas 67202, within ten days after the completion of the well, regardless of how the well was completed.

Attach separate letter of request if the information is to be held confidential. If confidential, only file one copy. Information on side one will be of public record, and side two will then be held confidential.

Circle one: Oil, Gas, Dry SWD, OWWO, Injection. Type and complete ALL sections. Applications must be filed for dual completion, commingling, SWD and injection.

Attach wireline logs (i.e. electrical log, sonic log, gamma ray neutron log, etc.). KCC # (316) 263-3238. (Rules 82-2-105 & 82-2-125)

OPERATOR D. R. Lauck Oil Company, Inc.
ADDRESS 221 S. Broadway, Suite 400
Wichita, Kansas 67202

API NO. 15-047-20,986-0000
COUNTY Edwards
FIELD Wil

**CONTACT PERSON Stella Lipps, Office Secretary
PHONE 263-8267

PROD. FORMATION None--D&A.
LEASE Parker "D"

PURCHASER None -- Dry Hole.
ADDRESS


WELL NO. 1
WELL LOCATION 1650' FSL & 290' FEL SW/4

DRILLING D. R. Lauck Oil Company, Inc.
CONTRACTOR ADDRESS 221 S. Broadway, Suite 400
Wichita, Kansas 67202

1650 Ft. from South Line and
290 Ft. from East Line of
the SW/4 SEC. 29 TWP. 25S RGE. 16W

PLUGGING Allied Cementing Co.
CONTRACTOR ADDRESS Box 31
Russell, Kansas 67202

WELL PLAT

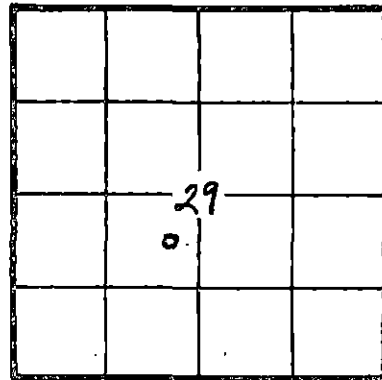

KCC
KGS
(Office Use)

TOTAL DEPTH 4520 PBD

SPUD DATE 12-18-82 DATE COMPLETED 1-10-82

ELEV: GR 2080 DF 2083 KB 2085

DRILLED WITH (CABLE) (ROTARY) (AIR) TOOLS

Amount of surface pipe set and cemented 362.09' set at 369'. DV Tool Used? No

AFFIDAVIT

STATE OF KANSAS, COUNTY OF SEDGWICK SS, I,

John D. Knightley OF LAWFUL AGE, BEING FIRST DULY SWORN UPON HIS OATH,

DEPOSES THAT HE IS Secretary-Landman (FOR)(OF) D. R. Lauck Oil Company, Inc.

OPERATOR OF THE Parker "D" LEASE, AND IS DULY AUTHORIZED TO MAKE

THIS AFFIDAVIT FOR AND ON THE BEHALF OF SAID OPERATOR, THAT WELL NO. 1 ON

SAID LEASE HAS BEEN COMPLETED AS OF THE 10th DAY OF January, 19 82, AND THAT

ALL INFORMATION ENTERED HEREIN WITH RESPECT TO SAID WELL IS TRUE AND CORRECT.

FURTHER AFFIANT SAITH NOT.

(S) [Signature]


SUBSCRIBED AND SWORN BEFORE ME THIS 15th DAY OF January, 19 82.

[Signature]
NOTARY PUBLIC

MY COMMISSION EXPIRES: March 12, 1983

**The person who can be reached by phone regarding any questions concerning this information. Within 45 days of completion, a witnessed initial test by the Commission is required if the well produces more than 25 BOPD or is located in a Basic Order Pool.

RECEIVED
KANSAS CORPORATION COMMISSION
1-18-82
18 1982
CONSERVATION DIVISION
Wichita, Kansas

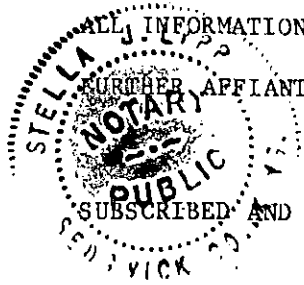

SIDE TWO

WELL LOG

Show all important zones of porosity and contents thereof; cored intervals, and all drill-stem tests, including depth interval tested, cushion used, time tool open, flowing and shut-in pressures, and recoveries.

SHOW GEOLOGICAL MARKERS, LOGS RUN, OR OTHER DESCRIPTIVE INFORMATION.

FORMATION DESCRIPTION, CONTENTS, ETC.	TOP	BOTTOM	NAME	DEPTH
There were no drill stem tests run on this well.			FORMATION TOPS	Welex Log
			Heebner	3768-1683
			Brown Lime	3912-1827
			Lansing	3923-1838
			Cherokee	4379-2294
			Mississippi	4432-2347
			Kinderhook Shale	4454-2369
			Kinderhook Sand	4477-2392
		LTD	4521	
		RTD	4520	

Report of all strings set — surface, intermediate, production, etc. CASING RECORD (New) or (Used)

Purpose of string	Size hole drilled	Size casing set (in O.D.)	Weight lbs/ft.	Setting depth	Type cement	Sacks	Type and percent additives
Surface Casing	12-1/4"	8-5/8"	28#	369'	Common	275	2% Gel, 3% CaCl ₂

LINER RECORD

PERFORATION RECORD

Top, ft.	Bottom, ft.	Sacks cement	Shots per ft.	Size & type	Depth interval

TUBING RECORD

Size	Setting depth	Packer set at

ACID, FRACTURE, SHOT, CEMENT SQUEEZE RECORD

Amount and kind of material used	Depth interval treated

Date of first production	Producing method (flowing, pumping, gas lift, etc.)	Gravity

RATE OF PRODUCTION PER 24 HOURS	Oil	Gas	Water	%	Gas-oil ratio
	bbls.	bbls.	MCF		bbls.

Disposition of gas (vented, used on lease or sold)	Perforations

