


15-047-20(2)-0000

STATE OF KANSAS
STATE CORPORATION COMMISSION

Form CP-4

Give All Information Completely
Make Required Affidavit
Mail or Deliver Report to:
Conservation Division
State Corporation Commission
P. O. Box 17027
Wichita, Kansas 67217
NORTH

WELL PLUGGING RECORD

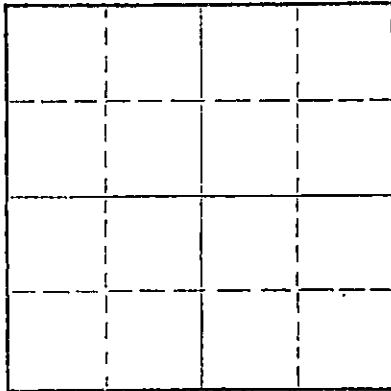

Locate well correctly on above
Section Plat

Edwards County. Sec. 6 Twp. 26S Rge. (E) 18W (W)
Location as "NE/CNW/SW" or footage from lines C NW NE
Lease Owner Chaparral Exploration Company
Lease Name Woods Well No. 1
Office Address P.O. Box 2041, Abilene, Texas 79604
Character of Well (completed as Oil, Gas or Dry Hole) Dry Hole
Date well completed 5-18 1972
Application for plugging filed 5-18 1972
Application for plugging approved 5-18 1972
Plugging commenced 5-18 1972
Plugging completed 5-18 1972
Reason for abandonment of well or producing formation No commercial quantities of oil or gas encountered.
If a producing well is abandoned, date of last production 19
Was permission obtained from the Conservation Division or its agents before plugging was commenced? Yes

Name of Conservation Agent who supervised plugging of this well G. R. Biberstein
Producing formation _____ Depth to top _____ Bottom _____ Total Depth of Well 3730 Feet
Show depth and thickness of all water, oil and gas formations.

OIL, GAS OR WATER RECORDS				CASING RECORD		
FORMATION	CONTENT	FROM	TO	SIZE	PUT IN	PULLED OUT
Surface Hole	Water	Surface	332'	8-5/8"	324'	None

Describe in detail the manner in which the well was plugged, indicating where the mud fluid was placed and the method or methods used in introducing it into the hole. If cement or other plugs were used, state the character of same and depth placed, from _____ feet to _____ feet for each plug set.

Fluid to 650', plug, 50 sx cement;
Fluid to 250', plug, 25 sx cement;
Fluid to 40', plug, 15 sx cement;
Two sacks cement in rat hole.

RECEIVED
STATE CORPORATION COMMISSION

MAY 25 1972

CONSERVATION DIVISION
Wichita, Kansas

5-25-1972

(If additional description is necessary, use BACK of this sheet)
Name of Plugging Contractor D N B DRILLING, INC.
Address 737 First Nat'l Bank Bldg., Wichita, Kansas 67202

STATE OF KANSAS, COUNTY OF _____, ss.
JAMES L. DONELSON (employee of owner) or (owner or operator) of the above-described well, being first duly sworn on oath, says: That I have knowledge of the facts, statements, and matters herein contained and the log of the above-described well as filed and that the same are true and correct. So help me God.

(Signature) James L. Donelson
737 First Nat'l Bank Bldg., Wichita, Ks.
(Address)

SUBSCRIBED AND SWORN TO before me this 23rd day of May, 1972

My commission expires August 25, 1972

Ella Priess
Notary Public.

15-047-20171-0000

RECEIVED
STATE CORPORATION COMMISSION

MAY 25 1972

CONSERVATION DIVISION
Wichita, Kansas

DRILLERS' LOG

CHAPARRAL EXPLORATION COMPANY
No. 1 Woods
C NW NE, Sec. 6-26S-18W
Edwards County, Kansas

Elev: 2195 R.B.

Commenced: 5-9 -72
Completed: 5-18-72

Surface Casing: 324' of
8-5/8" cemented w/300 sx
cement, 38 cc. 5-9-72

<u>FORMATION</u>	<u>DEPTH</u>
Surface Hole	0 - 332
Shale, Sand & Red Bed	332 - 1268
Anhydrite	1268 - 1312
Shale	1312 - 1830
Shale & Lime	1830 - 2250
Lime	2250 - 3730 T.D.

I do hereby certify that the foregoing statements are true and correct to the best of my knowledge and belief.

D N B DRILLING, INC.

James L. Donelson
JAMES L. DONELSON

STATE OF KANSAS: ss:

Subscribed and sworn to before me, the undersigned, a Notary Public in and for said state, this 23rd day of May 1972.

My Commission Expires:
August 25, 1972

Ella Priess
Ella Priess, Notary Public