


WELL PLUGGING RECORD

Give All Information Completely
Make Required Affidavit
Mail or Deliver Report to:
Conservation Division
State Corporation Commission
212 North Market, Insurance Bldg.
Wichita, Kansas

Edwards County. Sec. 11 Twp. 26 Rge. 18 (E) W (W)
Location as "NE/CNW/SW" or footage from lines C NW NW Company
Lease Owner D.R. Lauck Oil Company, Inc. & Southland Royalty
Lease Name Hetrick Well No. 2
Office Address 301 South Broadway, Wichita, Kansas
Character of Well (completed as Oil, Gas or Dry Hole) Dry Hole
Date well completed June 11 1960
Application for plugging filed June 11 1960
Application for plugging approved June 11 1960
Plugging commenced June 11 1960
Plugging completed June 11 1960
Reason for abandonment of well or producing formation
dry hole
If a producing well is abandoned, date of last production _____ 19____
Was permission obtained from the Conservation Division or its agents before plugging was commenced? yes

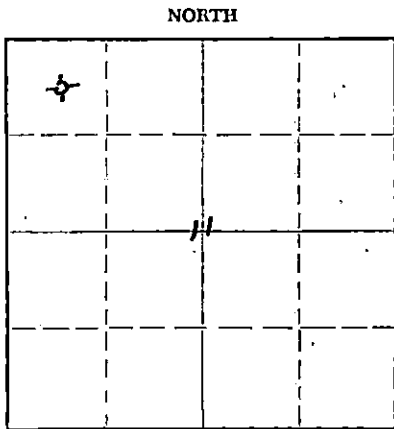

Locate well correctly on above Section Plat

Name of Conservation Agent who supervised plugging of this well Mr. Frank Broadfoot
Producing formation _____ Depth to top _____ Bottom _____ Total-Depth of Well 4775 Feet
Show depth and thickness of all water, oil and gas formations.

OIL, GAS OR WATER RECORDS

CASING RECORD

FORMATION	CONTENT	FROM	TO	SIZE	PUT IN	PULLED OUT
		0	284	8 5/8"	284	none

Describe in detail the manner in which the well was plugged, indicating where the mud fluid was placed and the method or methods used in introducing it into the hole. If cement or other plugs were used, state the character of same and depth placed, from _____ feet to _____ feet for each plug set.

hole filed with mud 4775-245
plug 245-241
20 sacks cement 241-201
mud 201-35
plug 35-31
cement 31-6 bottom of cellar

RECEIVED
STATE CORPORATION COMMISSION

JUN 24 1960

6-24-1960

CONSERVATION DIVISION
Wichita, Kansas

(If additional description is necessary, use BACK of this sheet)
Name of Plugging Contractor Globe Cementing Company
Address Great Bend, Kansas

STATE OF Kansas COUNTY OF Sedgwick, ss.
John H. Knightley (employee of owner) or (owner/proprietor) of the above-described well, being first duly sworn on oath, says: That I have knowledge of the facts, statements, and matters herein contained and the log of the above-described well as filed and that the same are true and correct. (So help me God.)

(Signature) John H. Knightley
301 South Broadway, Wichita, Kansas
(Address)

SUBSCRIBED AND SWORN to before me this 20 day of June, 1960

Delmar S. Ramsey
Notary Public.

My commission expires September 4, 1962

D. R. LAUCK OIL COMPANY, INC.

and

SOUTHLAND ROYALTY COMPANY

15-047-10060-0000

Hetrick #2

C NW NW Sec. 11-26S-18W
Edwards County, Kansas

Commenced: May 24, 1960
Completed: June 11, 1960

Casing Record: 284' 8 5/8" cemented with 200 sacks
calcium chloride 4 sacks

Elevation: GR 2158; DF 2161; KB 2163

Drillers Log

Tops

Sample

Schlumberger

Clay	20			
Sand	225	Heebner	3944-1781	3943-1780
Shale	284	Toronto	3960-1797	3960-1797
Blue Shale	375	Douglas	3982-1819	3982-1819
Shale	450	Brown Lime	4078-1915	4078-1915
Sand	460	Lansing	4090-1927	4090-1927
Shale	470	Base Kansas City	4456-2293	4459-2296
Sand	520	Cherokee Sand	4616-2453	4616-2453
Red Bed (Sandy)	600	Mississippian	4631-2468	4632-2469
Sand	640	Kinderhook Sand	4698-2535	4700-2537
Red Bed (Sand Streaks)	750	Viola	4754-2593	4760-2597
Anhydrite	770	Rotary Total Depth	4775-2612	4775-2612
Red Bed & Shells	1235			
Anhydrite	1250	Core #1	4610-4633;	Recovered 22 1/2 feet
Shale & Red Bed	1675	Core #2	4633-4671;	Recovered 38 feet
Shale & Shells	1880	Core #3	4671-4688;	Recovered 17 feet
Shale & Lime	2075	Core #4	4688-4712;	Recovered 23 feet
Shale & Shells	2210	Core #5	4712-4732;	Recovered 19 1/2 feet
Lime	2290			
Lime & Shale	2875	DST #1:	4600-4671	Open one hour. Strong blow throughout. Recovered 120 feet heavily oil and gas cut mud. 250 feet slightly oil and heavily gas cut mud. 1290 feet salt water. ISIP 1312# in 30 minutes. FSIP 1115# in 30 minutes. FP 335-912#
Shale & Lime	3025			
Lime & Shale	3125			
Shale & Lime	3520			
Lime & Shale	3575			
Lime	3615			
Lime (Broken)	3740			
Lime	3870			
Lime & Shale	3990	DST #2:	4600-4637	Straddle Packers. Open 1 hour. Weak intermittent blow. Flushed in 30 minutes. Weak blow 6 minutes and died. Recovered 20 feet mud. ISIP 1525# in 30 minutes. FSIP 150# in 30 minutes. FP 65-85#
Cherty Lime & Shale	3982			
Shale & Lime	4025			
Shale (Douglas)	4025			
Brown Lime	4078			
Lansing	4455			
Lime & Shale	4575			
Lime	4610	D & A		
Lime & Chert (Coring)	4732			
Sand & Shale	4754			
Viola	4775	RTD		

RECEIVED
STATE CORPORATION COMMISSION

JUN 24 1960

CONSERVATION DIVISION
Wichita, Kansas