


Give All Information Completely  
Make Required Affidavit  
Mail or Deliver Report to:  
Conservation Division  
State Corporation Commission  
212 North Market, Insurance Bldg.  
Wichita, Kansas

WELL PLUGGING RECORD

Edwards County. Sec. 11 Twp. 26S Rge. 18 (EXW) (W)

Location as "NE/CNW/SW" or footage from lines C SW NE  
Lease Owner D. R. Lauck Oil Company, Inc.  
Lease Name Newsom Well No. 2  
Office Address 301 South Broadway Wichita 2 Kansas  
Character of Well (completed as Oil, Gas or Dry Hole) dry hole  
Date well completed August 3 19 59  
Application for plugging filed August 3 19 59  
Application for plugging approved August 3 19 59  
Plugging commenced August 3 19 59  
Plugging completed August 3 19 59  
Reason for abandonment of well or producing formation dry hole

NORTH

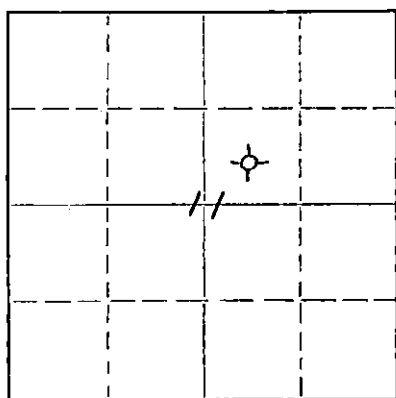

Locate well correctly on above Section Plat

If a producing well is abandoned, date of last production \_\_\_\_\_ 19\_\_\_\_  
Was permission obtained from the Conservation Division or its agents before plugging was commenced? yes

Name of Conservation Agent who supervised plugging of this well Frank Broadfoot  
Producing formation \_\_\_\_\_ Depth to top \_\_\_\_\_ Bottom \_\_\_\_\_ Total Depth of Well 4830 Feet  
Show depth and thickness of all water, oil and gas formations.

OIL, GAS OR WATER RECORDS

CASING RECORD

FORMATION	CONTENT	FROM	TO	SIZE	PUT IN	PULLED OUT
		0	283	8 5/8"	283	none

Describe in detail the manner in which the well was plugged, indicating where the mud fluid was placed and the method or methods used in introducing it into the hole. If cement or other plugs were used, state the character of same and depth placed, from \_\_\_\_\_ feet to \_\_\_\_\_ feet for each plug set.

hole filled with mud 4830 - 240  
plug 240 - 236  
cement 236 - 35  
plug 35 - 31  
cement 31 - 6' bottom of cellar

RECEIVED  
STATE CORPORATION COMMISSION

AUG 10 1959

CONSERVATION DIVISION  
Wichita, Kansas

(If additional description is necessary, use BACK of this sheet)  
Name of Plugging Contractor Globe Cementing Company, Inc.  
Address Great Bend Kansas

STATE OF Kansas, COUNTY OF Sedgwick, ss.  
John H. Knightley (employee of owner) or (owner or operator) of the above-described well, being first duly sworn on oath, says: That I have knowledge of the facts, statements, and matters herein contained and the log of the above-described well as filed and that the same are true and correct. So help me God.

(Signature) John H. Knightley  
Wichita Kansas  
(Address)

SUBSCRIBED AND SWORN TO before me this 6th day of August, 19 59  
Elizabeth Kay Notary Public.

My commission expires Sept. 14, 1959

PLUGGING  
FILE SEC. 11 T. 26 R. 18W  
BOOK PAGE 58 LINE 36

D. R. Lauck Oil Company, Inc.  
& Southland Royalty Company

15-047-10063-0000

Newsom #2

C SW NE Sec.11-26S-18W  
Edwards County Kansas

Commenced: July 17, 1959  
Completed: August 3, 1959

Casing Record: 283' 8 5/8" cem.with 200 sacks  
Calcium Chloride 4 "

Elevation: GR 2156; DF 2158; KB 2160

Drillers Log

Tops

sand	220	Heebner	3889-1729	3890-1730
shale	470	Toronto	3904-1744	3905-1745
sand	520	Douglas	3925-1765	3925-1765
red bed	570	Brown Lime	4025-1865	4022-1862
red bed & shells	1175	Lansing	4040-1880	4031-1871
Anhydrite	1220	Base Kansas City		4390-2230
shale & shells	2140	Kinderhook sand	4538-2378	4542-2382
Lime & shale	2410	Biola	4589-2429	4590-2430
shale & lime	2770	Simpson Dolomite	4720-2560	4721-2561
Lime & shale	2980	Arbuckle	4808-2648	4812-2652
shale & lime	3090	Rotary Total Depth	4830-2670	4829-2669
Lime & shale	3175			
Shale & lime	3310	DST #1 (J)	4531-4560 open 1 hr;	
Broken lime	3405		strong blow thruout; gas to	
Lime & shale	3585		the surface in 26 min.	
Lime broken	3695		Recov. 540 ft of gas cut mud;	
lime	3760		ISIP 2340 ? in 30 min.	
Lime & shale	3860		FSDP 1920? in 30 min.	
Lime	3910		IFP 105# FFP 225#	
shale	3920			
shale & lime	3995	DST #2 (J)	4532-4590 open 1 hr; good	
Lime & shale	4053		blow; gas to surface after	
Lime	4419		shut in; recov. 535 ft of	
Lime & shale	4505		gas cut mud; 240 ft of gas	
Lime	4555		cut watery mud; ISIP 2185?	
sand	4569		in 30 min.	
sand & lime	4590		FSIP 1460 in 30 min;	
lime	4640		IFP 300# FFP 360#	
chert	4700			
chert & lime	4760			
lime	4830	R.T.D.		

D & A

PLUGGING  
FILE SEC. 11 T26 R18W  
BOOK PAGE 58 LINE 36

RECEIVED  
STATE OF KANSAS  
AUG 10 1959  
CONSERVATION DIVISION  
Wichita, Kansas