

STATE OF KANSAS
STATE CORPORATION COMMISSION

WELL PLUGGING RECORD

Give All Information Completely
Make Required Affidavit
Mail or Deliver Report to:
Conservation Division
State Corporation Commission
211 No. Broadway
Wichita, Kansas

Edwards County. Sec. 11 Twp. 26S Rge. 18W (E) (W)

Location as "NE/CNW/SW" or footage from lines SW NE

Lease Owner Western Petroleum Co., Inc.

Lease Name Newson Well No. 1

Office Address Box 65, Great Bend, Kansas

Character of Well (completed as Oil, Gas or Dry Hole) Dry Hole

Date well completed January 9, 19 65

Application for plugging filed January 10, 19 65

Application for plugging approved January 10, 19 65


Plugging commenced 5:00 a.m. January 10, 19 65

Plugging completed 8:00 a.m. January 10, 19 65

Reason for abandonment of well or producing formation Dry Hole

If a producing well is abandoned, date of last production _____ 19 _____

Was permission obtained from the Conservation Division or its agents before plugging was commenced? _____

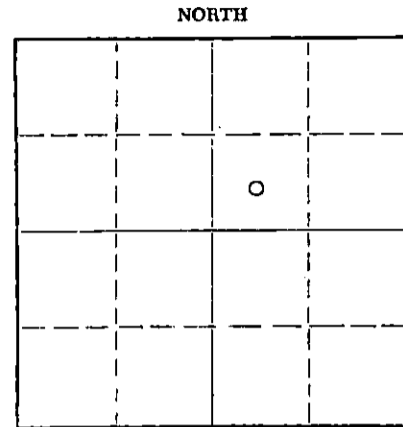

Locate well correctly on above
Section Plat

Name of Conservation Agent who supervised plugging of this well Archie Elving

Producing formation _____ Depth to top _____ Bottom _____ Total Depth of Well _____ Feet

Show depth and thickness of all water, oil and gas formations.

OIL, GAS OR WATER RECORDS

CASING RECORD

FORMATION	CONTENT	FROM	TO	SIZE	PUT IN	PULLED OUT

Describe in detail the manner in which the well was plugged, indicating where the mud fluid was placed and the method or methods used in introducing it into the hole. If cement or other plugs were used, state the character of same and depth placed, from _____ feet to _____ feet for each plug set.

Pushed wooden plug and 1/4 sack hulls to 275' with drill pipe.
Cemented with 25 sacks cement through drill pipe.
Filled hole to 40' with rotary mud.
Pushed wooden plug to 40'. Bridged plug with hulls and 2 sacks dry
cement. Cemented with 10 sacks.
Job completed @ 8:00 a.m.

RECEIVED
STATE CORPORATION COMMISSION

JAN 12 1965
1-12-1965

(If additional description is necessary, use BACK of this sheet)
CONSERVATION DIVISION
Wichita, Kansas

Name of Plugging Contractor _____
Address _____

STATE OF KANSAS, COUNTY OF BARTON, ss.

F. L. Copeland (employee of owner) or (owner or operator) of the above-described well, being first duly sworn on oath, says: That I have knowledge of the facts, statements, and matters herein contained and the log of the above-described well as filed and that the same are true and correct. So help me God.

(Signature) F. L. Copeland
925 Patton Road, Great Bend, Kansas
(Address)

SUBSCRIBED AND SWORN TO before me this 11th day of January, 1965

My commission expires 10/19/68 L. S. Brown Notary Public.

DRILLER'S LOG

15-047-10063-00-01

Newsom #1 - Washdown

COMPANY: Western Petroleum Co., Inc.
 CONTRACTOR: Western Petroleum Co., Inc.
 WASHDOWN COMMENCED: January 6, 1965
 WASHDOWN COMPLETED: January 10, 1965
 LOCATION: SW NE
 Section 11-26S-18W
 Edwards County, Kansas
 ELEVATION: 2160 KB
 CASING: 8" Surface Casing @ 283'

RECEIVED
 STATE CORPORATION COMMISSION
 JAN 28 1965
 CONSERVATION DIVISION
 Wichita, Kansas

Well was washed down to a total depth of 3365'.
 Original well drilled by D. R. Lauck Drilling.
 Completed: 8/7/59
 Old Total Depth: 4829'
 No new formations penetrated.

DST #1 - 3172-3310 (Wabaunsee - Straddle test). Bottom packer failed.

DST #2 - 3172-3257 (Wabaunsee). Packer failure.

WLT #1 - 3252-54½. Open 50", ISIP 1165#/1". Sampling pressure 0-1130#/30". IHMP 1790#. Recovered .17 cu. ft. free gas and 45,300 cc water. Rw = .052 @ 100°F, Rmf = .045 @ 100°F.

WLT #2 - 3237-39½. Open 120". ISIP 1060#/31". Sampling pressure less than 100#. Recovered 4300 cc filtrate water. Rw = .047 @ 100°F, Rmf = .045 @ 100°F.

STATE OF KANSAS)
 COUNTY OF BARTON) SS

I, the undersigned, being duly sworn on oath, state that the above statement and log are true and a correct record and log of the well washed down at the location above described.

WESTERN PETROLEUM CO., INC.

F. L. Copeland
 F. L. Copeland

Subscribed and sworn to before me this 26th day of January, 1965.

L. S. Brown
 L. S. Brown

My commission expires 10/19/68.