

15-047-10113-0000



STATE OF KANSAS  
STATE CORPORATION COMMISSION

WELL PLUGGING RECORD

OR

FORMATION PLUGGING RECORD

Give All Information Completely  
Make Required Affidavit  
Mail or Deliver Report to:  
Conservation Division  
State Corporation Commission  
800 Bittling Building  
Wichita, Kansas

Edwards County. Sec. 11 Twp. 26S Rge. (E) 18 (W)

Location as "NE 1/4 NW 1/4 SW 1/4" or footage from lines SE 1/4 NE 1/4 SE 1/4

Lease Owner Stanolind Oil & Gas Company

Lease Name W. H. Newsom Well No. 1

Office Address Box 591, Tulsa, Oklahoma

Character of Well (completed as Oil, Gas or Dry Hole) Dry Hole

Date well completed April 8 19 43  
April 9 19 43

T Application for plugging filed April 9 19 43

26 Application for plugging approved April 9 19 43


S Plugging commenced April 10 19 43

1 Plugging completed April 10 19 43

Reason for abandonment of well or producing formation Dry hole

If a producing well is abandoned, date of last production X 19

Was permission obtained from the Conservation Division or its agents before plugging was commenced? yes

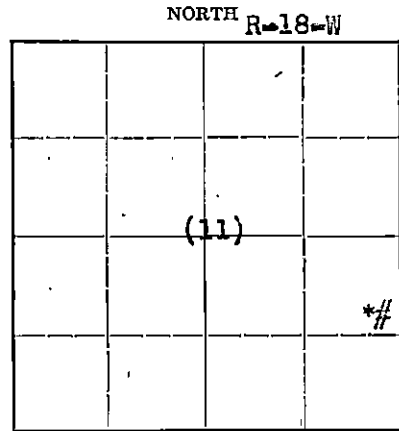

Locate well correctly on above Section Flat

Name of Conservation Agent who supervised plugging of this well C. T. Alexander

Producing formation Arbuckle Depth to top 4805 Bottom 4845 Total Depth of Well 4845 Feet

Show depth and thickness of all water, oil and gas formations.


OIL, GAS OR WATER RECORDS

CASING RECORD

Formation	Content	From	To	Size	Put In	Pulled Out
Arbuckle	Dry	4805	4845	8 5/8" O.D.	265' 3"	None

Describe in detail the manner in which the well was plugged, indicating where the mud fluid was placed and the method or methods used in introducing it into the hole. If cement or other plugs were used, state the character of same and depth placed, from feet to feet for each plug set.

Mud - 4845' - 270'  
Bridge at 270' and cement to 225' (15 sacks)  
Mud - 225' to 26'  
Cement 26' to 6' (15 sacks)  
Surface Soils 6' - 0'

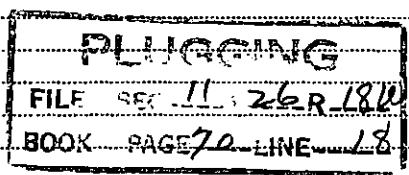

(If additional description is necessary, use BACK of this sheet)

Correspondence regarding this well should be addressed to Stanolind Oil & Gas Company  
Address Box 591, Tulsa, Oklahoma

STATE OF Kansas COUNTY OF Stafford ss.

C. B. Snyder (employee of owner) or (owner or operator) of the above-described well, being first duly sworn on oath, says: That I have knowledge of the facts, statements, and matters herein contained and the log of the above-described well as filed and that the same are true and correct. So help me God.

(Signature) C. B. Snyder, Field Superintendent

Rural Route #2, Stafford, Kansas (Address)

SUBSCRIBED AND SWORN to before me this 21st day of April, 19 43

George A. Banks Notary Public

My commission expires February 6, 1946



FORMATION RECORD

Give detailed description and thickness of all formations drilled through and contents of sand, whether dry, water, oil or gas.

Formation	Top	Bottom	Formation	Top	Bottom
Cellar	0	8' 8"			
Surface Sand	8' 8"	70			
Sand	70	225			
Shale & shells	225	280			
Shale	280	400			
Sand	400	500			
Red bed	500	582			
White lime	582	609			
Red bed	609	900			
Red shale & shells	900	1105			
Red bed & shells	1105	1180			
Anhydrite	1180	1190			
Lime & red bed	1190	1220			
Shale	1220	1485			
Shale & shells	1485	1655			
Shale & lime	1655	1760			
Shale	1760	1895			
Shale & Shells	1895	2050			
Shale & lime shells	2050	2160			
Broken lime	2160	2305			
Lime	2305	2370			
Broken Lime	2370	2490			
Lime	2490	2550			
Broken lime	2550	2605			
Lime	2605	2815			
Broken lime	2815	2925			
Lime	2925	2995			
Shale	2995	3045			
Broken lime	3045	3105			
Shale & lime	3105	3170			
Shale	3170	3230			
Shale & lime	3230	3275			
Hard sand & shale	3275	3285			
Broken lime	3285	3400			
Shale & lime	3400	3475			
Shale	3475	3510			
Lime	3510	3560			
Broken lime	3560	3875			
Lime	3875	3970			
Shale	3970	4032			
Lime	4032	4143			
Hard lime	4143	4152			
Soft lime	4152	4162			
Lime (hard)	4162	4173			
Lime	4173	4199			
Lime (soft)	4199	4227			
Lime	4227	4332			
Lime (soft)	4332	4337			
Lime	4337	4407			
Shale	4407	4435			
Broken lime	4435	4470			
Lime	4470	4510			
Broken lime	4510	4541			
Hard sand	4541	4545			
Sand	4545	4611			
Sand & chert	4611	4630			
Chert	4630	4637			
Cherty lime	4637	4647			
Lime	4647	4745			
Lime & Shale	4745	4772			
Shale	4772	4805			
Lime	4805	4845			
Total Depth	4845				