


WELL PLUGGING RECORD

Give All Information Completely  
Make Required Affidavit  
Mail or Deliver Report to:  
Conservation Division  
State Corporation Commission  
211 No. Broadway  
Wichita, Kansas

Edwards County. Sec. 14 Twp. 26s Rge. 18 (E) W (W)

Location as "NE/CNW%SW%" or footage from lines C-W/2-NW-NE  
Lease Owner Fatzer Hudson Petroleum Company  
Lease Name Fatzer Well No. 1  
Office Address 1112 Southwest Blvd., Kansas City, Kansas  
Character of Well (completed as Oil, Gas or Dry Hole) Dry Hole  
Date well completed October 6, 19 59  
Application for plugging filed October 6, 19 59  
Application for plugging approved 19 59  
Plugging commenced October 6, 19 59  
Plugging completed October 6, 19 59  
Reason for abandonment of well or producing formation Dry Hole

NORTH

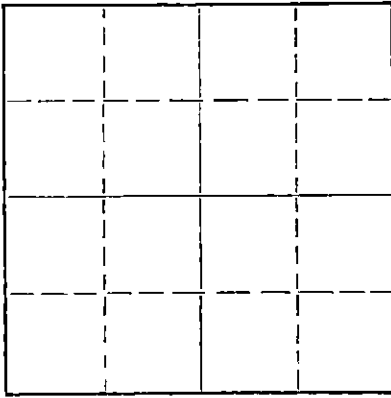

Locate well correctly on above  
Section Plat

If a producing well is abandoned, date of last production 19  
Was permission obtained from the Conservation Division or its agents before plugging was commenced? yes

Name of Conservation Agent who supervised plugging of this well Frank Broadfoot  
Producing formation \_\_\_\_\_ Depth to top \_\_\_\_\_ Bottom \_\_\_\_\_ Total Depth of Well 4645 Feet  
Show depth and thickness of all water, oil and gas formations.

OIL, GAS OR WATER RECORDS

CASING RECORD

FORMATION	CONTENT	FROM	TO	SIZE	PUT IN	PULLED OUT
				8 5/8"	301'	

Describe in detail the manner in which the well was plugged, indicating where the mud fluid was placed and the method or methods used in introducing it into the hole. If cement or other plugs were used, state the character of same and depth placed, from \_\_\_\_\_ feet to \_\_\_\_\_ feet for each plug set.

Filled hole to 240', set plug with hulls, mixed 20 sacks cement through drill pipe. Filled hole with mud, set plug at 35', mixed 10 sacks cement through drill pipe.

(If additional description is necessary, use BACK of this sheet)

Name of Plugging Contractor Hilton Drilling Company, Inc.  
Address 925 Patton Road, Great Bend, Kansas

STATE OF KANSAS, COUNTY OF WYANDOTTE, ss.  
H. C. Hopkins (employee of owner) or (~~owner or operator~~) of the above-described well, being first duly sworn on oath, says: That I have knowledge of the facts, statements, and matters herein contained and the log of the above-described well as filed and that the same are true and correct. So help me God.

(Signature) H. C. Hopkins  
1112 Southwest Blvd., Kansas City, Kansas  
(Address)

SUBSCRIBED AND SWORN TO before me this 7th day of October, 19 59

My commission expires \_\_\_\_\_ My Commission Expires to \_\_\_\_\_ Notary Public.

RECEIVED  
STATE CORPORATION COMMISSION

OCT 8 1959

CONSERVATION DIVISION  
Wichita, Kansas

WELL LOG BUREAU--KANSAS GEOLOGICAL SOCIETY  
500 East Murdock, Wichita, Kansas


15-047-00093-0000

Company- HUDSON PETROLEUM CO.  
Farm- Patzer No. 1

SEC. 14 T. 26 R. 18W  
C W/2 NW NE

Total Depth. 4645'  
Comm. 9-21-59 Comp. 10-6-59  
Shot or Treated.  
Contractor. Hilton Drig.  
Issued. 12-5-59

County Edwards  
KANSAS

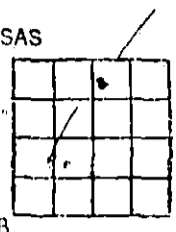

CASING:

8 5/8" 302' cem w/250 sx.

Elevation. 2168' KB

Production. Dry

Figures indicate Bottom of Formations.

sand	70
shale & sand	270
shale	440
red bed	600
gypsum	620
red bed, shale & shells	1030
red bed & shale	1176
Anhydrite	1200
shale	1540
shale & shells	2150
lime & shale	2430
lime	2510
lime & shale	2610
lime	2790
lime & shale	3869
lime	3935
lime & shale	4024
lime	4051
shale & lime	4153
lime	4546
chert, lime & shale	4645
Total Depth	

TOPS: SCOUT	
Heebner	3894
Brown Lime	4022
Lansing	4031
Viola	4507

**RECEIVED**  
STATE CORPORATION COMMISSION  
MAY 11 1966  
CONSERVATION DIVISION  
Wichita, Kansas