


Give All Information Completely  
Make Required Affidavit  
Mail or Deliver Report to:  
Conservation Division  
State Corporation Commission  
211 No. Broadway  
Wichita, Kansas

WELL PLUGGING RECORD

Edwards County. Sec. 15 Twp. 26S Rge. 18 (K) (W)  
Location as "NE/CNW/SW" or footage from lines C NE NE  
Lease Owner D. R. Lack Oil Company, Inc. & Southland Royalt  
Lease Name McClanahan "B" Company Well No. 1  
Office Address 301 South Broadway, Wichita 2, Kansas  
Character of Well (completed as Oil, Gas or Dry Hole) dry hole  
Date well completed September 7 19 59  
Application for plugging filed September 7 19 59  
Application for plugging approved September 7 19 59  
Plugging commenced September 7 19 59  
Plugging completed September 7 19 59  
Reason for abandonment of well or producing formation dry hole

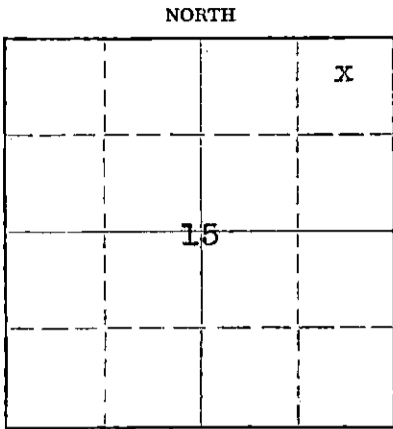

Locate well correctly on above Section Plat

If a producing well is abandoned, date of last production \_\_\_\_\_ 19 \_\_\_\_  
Was permission obtained from the Conservation Division or its agents before plugging was commenced? yes

Name of Conservation Agent who supervised plugging of this well Mr. Frank Broadfoot  
Producing formation \_\_\_\_\_ Depth to top \_\_\_\_\_ Bottom \_\_\_\_\_ Total Depth of Well 4850 Feet  
Show depth and thickness of all water, oil and gas formations.

OIL, GAS OR WATER RECORDS

CASING RECORD

FORMATION	CONTENT	FROM	TO	SIZE	PUT IN	PULLED OUT
		0	276	8 5/8	276'	none

Describe in detail the manner in which the well was plugged, indicating where the mud fluid was placed and the method or methods used in introducing it into the hole. If cement or other plugs were used, state the character of same and depth placed, from \_\_\_\_\_ feet to \_\_\_\_\_ feet for each plug set.

hole filled with mud 4850-240  
1/4 sack hulls & plug 240-236  
cement 236-196  
mud 196-35  
1/4 sack hulls & plug 35-31  
cement 31-6 bottom of cellar

(If additional description is necessary, use BACK of this sheet)

Name of Plugging Contractor Globe Cementing Company  
Address Great Bend, Kansas

STATE OF KANSAS, COUNTY OF SEDGWICK, ss.  
John H. Knightley (employee of owner) or (owner or operator) of the above-described well, being first duly sworn on oath, says: That I have knowledge of the facts, statements, and matters herein contained and the log of the above-described well as filed and that the same are true and correct. (So help me God.)

(Signature) John H. Knightley  
301 South Broadway, Wichita, 2, Kansas  
(Address)

SUBSCRIBED AND SWORN TO before me this 14 day of September, 19 59

Delmer Spamer  
Notary Public.

My commission expires September 4, 1962



PLUGGING

File Sec. 15 T 26 R 18W  
Book Page 2 Line 26

D. R. LAUCK OIL COMPANY, INC. and  
SOUTHLAND ROYALTY COMPANY

McClanahan "B" #1

C. NE NE Sec. 15-26S-18W  
Edwards County, Kansas

Commenced: August 21, 1959  
Completed: September 7, 1959

Casing Record: 276' 8 5/8" cemented with 210 sacks  
calcium chloride 4 sacks

Elevation: GR 2169; DF 2172; KB 2174

Drillers Log

Tops

Sand	215	Heebner	3966-1792	3969-1795
Shale	335	Douglas	4006-1832	4009-1835
Shale & Shells	470	Brown Lime	4101-1927	4105-1931
Sand	510	Lansing	4113-1939	4114-1940
Red Bed	575	Base Kansas City	4463-2289	4467-2293
Shale & Shells	2255	Cherokee Shale	4631-2457	4639-2465
Lime & Shale	2300	Cherokee Sand	4647-2473	4648-2474
Lime	2580	Cherty Conglomerate	4655-2481	4657-2483
Shale & Lime	2710	Mississippi Chert	4665-2491	4670-2496
Lime & Shale	2925	Kinderhook Shale	4725-2551	4726-2552
Broken Lime	3030	Kinderhook Sand	4753-2579	4757-2583
Shale & Lime	3186	Viola	4838-2664	4841-2667
Lime & Shale	3265	Rotary Total Depth	4850-2676	4851-2677
Broken Lime & Shale	3300			
Sand	3375			
Shale & Lime	3456			
Lime & Shale	3615			
Lime	3863			
Lime & Shale	3915			
Lime	3962			
Lime & Shale	4015			
Douglas Shale	4095			
Lime	4635			
Shale & Sand	4670			
Shale & Chert	4715			
Chert	4727			
Shale, Lime & Chert	4753			
Shale, Chert & Sand	4813			
Kinderhook Shale	4833			
Lime & Chert	4850	RTD		

DST #1 4654-4670 (J) - Open 60 minutes weak increasing to good blow. Recovered 30' drilling mud. No show. IBHP 1260# in 30 minutes; FBHP 620# in 30 minutes (still building); IFP 20#; FFP 20#; Temp 134 degree F.

D&A

**RECEIVED**  
STATE CORP COMMISSION

SEP 16 1959

CONSERVATION DIVISION  
Wichita, Kansas

**PLUGGING**

File Sec. 15-26-R-18W  
Book Page 3 Line 26