


STATE OF KANSAS  
STATE CORPORATION COMMISSION

WELL PLUGGING RECORD

Give All Information Completely  
Make Required Affidavit  
Mail or Deliver Report to  
Conservation Division  
State Corporation Comm.  
245 North Water  
Wichita, KS 67202

Stafford County. Sec. 28 Twp. 25S Rge. 14W ~~22W~~  
Location as "NE/CNW $\frac{1}{4}$ SW $\frac{1}{4}$ " or footage from lines \_\_\_\_\_  
63'SW NE SW NW  
Lease Owner Alpine Drilling & Dwight J. Wilson  
Lease Name Waters B Well No. 1  
Office Address 800 Bitting Building, Wichita, KS 67202  
Character of Well (Completed as Oil, Gas or Dry Hole) \_\_\_\_\_  
Dry Hole

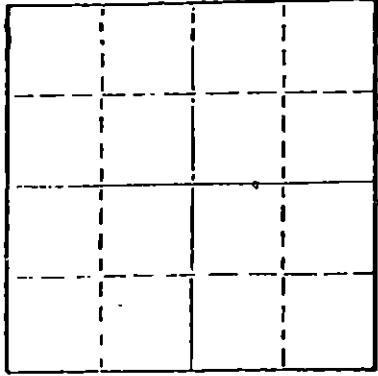

Locate well correctly on above  
Section Plat

Date Well completed October 25 1978  
Application for plugging filed October 25 1978  
Application for plugging approved October 25 1978  
Plugging commenced Midnight October 24 1978  
Plugging completed October 25 1978  
Reason for abandonment of well or producing formation \_\_\_\_\_

If a producing well is abandoned, date of last production \_\_\_\_\_ 19\_\_

Was permission obtained from the Conservation Division or its agents before plugging was commenced? yes

Name of Conservation Agent who supervised plugging of this well Bill Owens, Pratt, Kansas  
Producing formation \_\_\_\_\_ Depth to top \_\_\_\_\_ Bottom \_\_\_\_\_ Total Depth of Well 4297  
Show depth and thickness of all water, oil and gas formations.

OIL, GAS OR WATER RECORDS

CASING RECORD

FORMATION	CONTENT	FROM	TO	SIZE	PUT IN	PULLED OUT

Describe in detail the manner in which the well was plugged, indicating where the mud fluid was placed and the method or methods used in introducing it into the hold. If cement or other plugs were used, state the character of same and depth placed, from \_\_\_\_\_ feet to \_\_\_\_\_ feet for each plug set.

Plugged as follows: Filled hole w/mud, spotted 40 sx thru O.E. drill pipe @ 540', mud to 270', spotted 40 sx thru O.E. D.P., mud to 40', 1/2 sx hulls & wood plug for solid bridge, pumped 12 sx to base of cellar, 3 sx in rat hole - used common cement, completed @ 2 a.m. 10-25-78 by Allied. Witnessed by Bill Owens, State Plugger, Pratt, Kansas and Gary Bagby, Husky Drilling Co.

(If additional description is necessary, use BACK of this sheet)

Name of Plugging Contractor Husky Drilling Co., Inc.

STATE OF KANSAS COUNTY OF SEDGWICK, ss.  
Jon T. Williams, Jr. (employee of owner) or (owner or operator)


of the above-described well, being first duly sworn on oath, says: That I have knowledge of the facts, statements, and matters herein contained and the log of the above-described well as filed and that the same are true and correct. So help me God.

(Signature) [Signature]  
800 Bitting Building, Wichita, KS 67202  
(Address)

SUBSCRIBED AND SWORN TO before me this 25th day of October, 1978

Geraldine Stewart  
Geraldine Stewart Notary Public.

My commission expires January 12, 1981

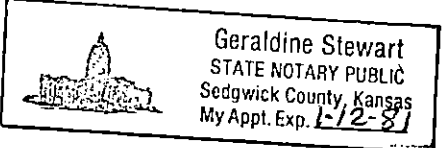

RECEIVED  
STATE CORPORATION COMMISSION

OCT 27 1978

CONSERVATION DIVISION  
Wichita, Kansas



800 Bitting Bldg  
Wichita, Kansas 67202  
Phone 316 - 263-7904  
Mobile Phone 316 - 793-7859 Unit 7070

October 26, 1978

WELL LOG- - - - -Waters-B #1  
Located: NE SW NW of Sec. 28-25S-14W  
Stafford County, Kansas.

OWNER: Alpine Drilling & Dwight J. Wilson  
ROTARY CONTRACTOR: Husky Drilling Co., Inc.

COMMENCED: October 17, 1978  
COMPLETED: October 25, 1978

Rotary Total Depth: 4297'

LOG

0 - 913 Sand & shale  
913 - 930 Anhydrite  
930 - 1890 Shale & Shells  
1890 - 3926 Shale & Lime  
3926 - 3960 Lime  
3960 - 4019 Lime & Shale  
4019 - 4126 Lime  
4126 - 4297 Lime & Shale

CASING RECORD:

Ran 7 jts. 8-5/8", 28#, 8V, Rge 3  
used csg., tallied 285.97', set  
@ 293' KB w/300 sx common, 2% gel,  
3% cc, circulated - plug down @  
10:30 p.m. 10-17-78 by Allied.

Plugged 10-25-78

RECEIVED  
STATE CORPORATION COMMISSION

OCT 27 1978

CONSERVATION DIVISION  
Wichita, Kansas