


STATE OF KANSAS
STATE CORPORATION COMMISSION

WELL PLUGGING RECORD

Give All Information Completely
Make Required Affidavit
Mail or Deliver Report to:
Conservation Division
State Corporation Commission
211 No. Broadway
Wichita, Kansas

NORTH

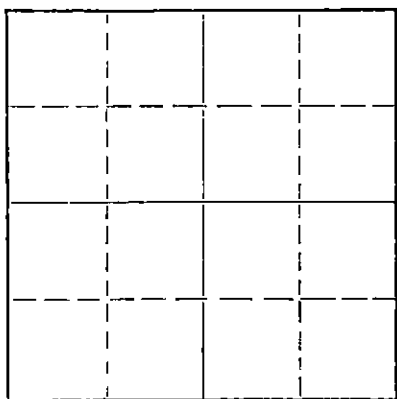

Locate well correctly on above
Section Plat

Stafford County. Sec. 29 Twp. 25S Rge. 14W (E) (W)
Location as "NE/CNW/SW" or footage from lines NE NE SE
Lease Owner Alpine Oil & Royalty Co., Inc.
Lease Name English Well No. 2
Office Address 1100 Bitting Building, Wichita, Kansas
Character of Well (completed as Oil, Gas or Dry Hole) Dry Hole
Date well completed June 15, 1957 19
Application for plugging filed December 6, 1957 19
Application for plugging approved December 9, 1957 19
Plugging commenced December 19, 1957 19
Plugging completed December 23, 1957 19
Reason for abandonment of well or producing formation Non-productive in
commercial quantities
If a producing well is abandoned, date of last production _____ 19
Was permission obtained from the Conservation Division or its agents before plugging was com-
menced? Yes

Name of Conservation Agent who supervised plugging of this well Frank Broadfoot
Producing formation _____ Depth to top _____ Bottom _____ Total Depth of Well 4075 Feet
Show depth and thickness of all water, oil and gas formations.

OIL, GAS OR WATER RECORDS

CASING RECORD

FORMATION	CONTENT	FROM	TO	SIZE	PUT IN	PULLED OUT
				8 5/8"	280'	Cemented
				5 1/2"	4075'	2901.55'

Describe in detail the manner in which the well was plugged, indicating where the mud fluid was placed and the method or methods used in introducing it into the hole. If cement or other plugs were used, state the character of same and depth placed, from _____ feet to _____ feet for each plug set.

Plugged back with sand to 3885 feet and dumped 5 sacks cement
Pulled casing. Mudded hole with chunk mud to 270 feet.
Set 5 foot rock bridge, mixed and dumped 20 sacks
cement. Mud to 35 feet, set 5 feet rock bridge, mix
and dump 10 sacks cement to base of cellar

RECEIVED
STATE CORPORATION COMMISSION
DEC 27 1957
CONSERVATION DIVISION
Wichita, Kansas

12-27-57

(If additional description is necessary, use BACK of this sheet)
Name of Plugging Contractor Ace Pipe Pulling Company
Address Box 304, Great Bend, Kansas

STATE OF Kansas, COUNTY OF Sedgwick, ss.
Dwight J. Wilson (employee of owner) or (owner or operator) of the above-described well, being first duly sworn on oath, says: That I have knowledge of the facts, statements, and matters herein contained and the log of the above-described well as filed and that the same are true and correct. So help me God.

(Signature) Dwight J. Wilson
1100 Bitting Building, Wichita, Kansas
(Address)

SUBSCRIBED AND SWORN to before me this 26th day of December, 19 57

Virginia Mundell
Virginia Mundell Notary Public.

My commission expires August 10, 1961

PLUGGING
FILE SEC 29T 25R 14W
BOOK PAGE 66 LINE 26

WELL LOG

ALPINE OIL & ROYALTY CO., INC.
Contractor: Quaker Drilling Co., Inc.
English No. 2
NE NE SE Sec. 29-25S-14W
Stafford County, Kansas

Commenced: April 20, 1957
Completed: May 1, 1957
Elevation: 2001 K. B.

Casing Record:

Set 8 5/8 inch casing at 280 feet with 225 sacks pozmix
Set 5 1/2 inch casing at 4075 feet with 225 sacks pozmix

(Figures Indicate the Bottom of the Formations)

<u>FORMATION</u>	<u>DEPTH</u>	<u>FORMATION TOPS</u>	
Sand	230	Heebner	3595 -1594
Shale	280	Brown Lime	3741 -1740
Red Bed and Shale	900	Lansing	3767 -1766
Anhydrite	912	Base of Kansas City	4062 -2061
Shale	945	Rotary Total Depth	4075 -2074
Shale and Shells	1645		
Shale and Lime	2790		
Shale	2945		
Shale and Lime	3270		
Lime and Shale	3400		
Shale and Lime	3490		
Lime and Shale	3615		
Shale and Lime	3715		
Lime	3770		
Lime and Shale	3830		
Shale and Lime	3910		
Lime	3986		
Shale and Lime	4075		

We hereby certify the foregoing to be a true and correct copy of the Driller's Log of the well drilled in the NE NE SE Section 29, Township 25 South, Range 14 West, Stafford County, Kansas.

QUAKER DRILLING CO., INC.

By: Thomas M. McCaul
Thomas M. McCaul, President

SUBSCRIBED AND SWORN TO before me a Notary Public this 6th day of May, 1957.

Virginia Mundell
Virginia Mundell, Notary Public

MY COMMISSION EXPIRES:
August 10, 1957

