

STATE OF KANSAS  
STATE CORPORATION COMMISSION


Form CP-4

Give All Information Completely  
Make Required Affidavit  
Mail or Deliver Report to:  
Conservation Division  
State Corporation Commission  
211 No. Broadway  
Wichita, Kansas

WELL PLUGGING RECORD

Stafford County, Sec. 29 Twp. 25S Rge. (E) 14 (W)

Location as "NE/CNW&SW" or footage from lines NE NE SW  
Lease Owner Shawver Armour, Inc - John Jennings  
Lease Name English Well No. 1  
Office Address 817 Central Building, Wichita, Kansas  
Character of Well (completed as Oil, Gas or Dry Hole) dry hole  
Date well completed January 28, 19 66  
Application for plugging filed " " 19 "  
Application for plugging approved " " 19 "  
Plugging commenced " " 19 "  
Plugging completed " " 19 "  
Reason for abandonment of well or producing formation Dry Hole

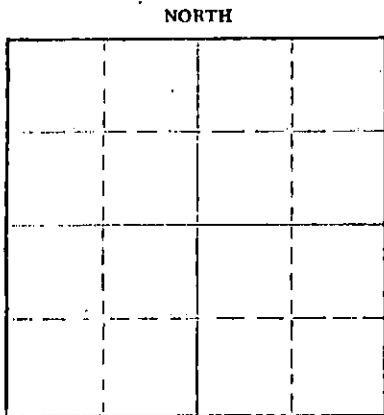

Locate well correctly on above Section Plat

If a producing well is abandoned, date of last production 19  
Was permission obtained from the Conservation Division or its agents before plugging was commenced? yes

Name of Conservation Agent who supervised plugging of this well Archie Evling, Pratt, Ks.  
Producing formation \_\_\_\_\_ Depth to top \_\_\_\_\_ Bottom \_\_\_\_\_ Total Depth of Well 3950 Feet  
Show depth and thickness of all water, oil and gas formations.

OIL, GAS OR WATER RECORDS

CASING RECORD

FORMATION	CONTENT	FROM	TO	SIZE	PUT IN	PULLED OUT
surface	water	-0-	316'	8 5/8"	316'	none

Describe in detail the manner in which the well was plugged, indicating where the mud fluid was placed and the method or methods used in introducing it into the hole. If cement or other plugs were used, state the character of same and depth placed, from \_\_\_\_\_ feet to \_\_\_\_\_ feet for each plug set.

Heavy mud to 275'  
#1 Plug 275' Howco plug 1/4 sacks hulls  
25 sacks cement thru DP  
#2 Plug @ 40' Howco plug 1/4 sack hulls 10 sacks cement.  
Bridged rat hole 7' w/2 sacks cement


RECEIVED  
STATE CORPORATION COMMISSION

FEB 9 1966

CONSERVATION DIVISION  
WICHITA, KANSAS

Name of Plugging Contractor Shawver Armour, Inc.  
Address 817 Central Building, Wichita, Kansas

(If additional description is necessary, use BACK of this sheet)

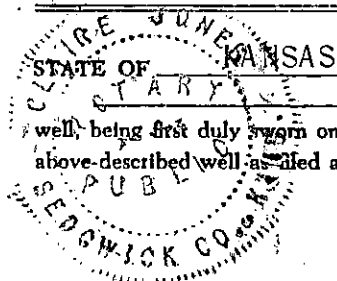

\_\_\_\_\_, COUNTY OF SEDGWICK, SS.  
(employee of owner) or (owner or operator) of the above-described

well, being first duly sworn on oath, says: That I have knowledge of the facts, statements, and matters herein contained and the log of the above-described well as filed and that the same are true and correct. So help me God.

(Signature) James M. Armour  
James M. Armour, 817 Central Bldg.  
Wichita, Kansas  
(Address)

Subscribed and sworn to before me this 8th day of February, 19 66

Claire Jones  
Notary Public.

My commission expires December 10, 1967.

