


STATE OF KANSAS
STATE CORPORATION COMMISSION

Give All Information Completely
Make Required Affidavit
Mail or Deliver Report to:
Conservation Division
State Corporation Commission
P. O. Box 17027
Wichita, Kansas 67217
NORTH

WELL PLUGGING RECORD

Alkay Regattia Inc
Stafford County, Sec. 29 Twp. 25 Rgs. 14 (E)W (W)

Location as "NE/CNW/SW" or footage from lines C SE SE
Lease Owner Okla. Fracturing Ser. ; Okla. City, Ok. 73112
Lease Name Southards Well No. #1
Office Address 630 United Founders Life Tower
Character of Well (completed as Oil, Gas or Dry Hole)
Date well completed _____ 19____
Application for plugging filed August 19 74
Application for plugging approved August 19 74
Plugging commenced August 7 19 74
Plugging completed August 27 19 74
Reason for abandonment of well or producing formation _____

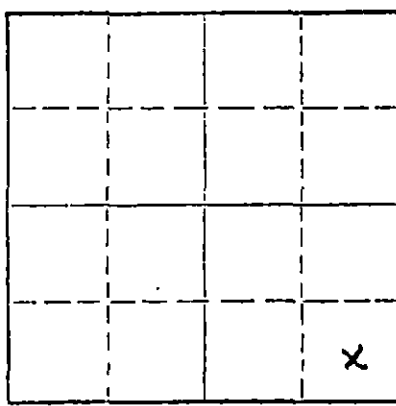

Locate well correctly on above Section Plat

If a producing well is abandoned, date of last production _____ 19____
Was permission obtained from the Conservation Division or its agents before plugging was commenced? Yes

Name of Conservation Agent who supervised plugging of this well Russell Biberstein
Producing formation _____ Depth to top _____ Bottom _____ Total Depth of Well _____ Feet
Show depth and thickness of all water, oil and gas formations.

OIL, GAS OR WATER RECORDS CASING RECORD

FORMATION	CONTENT	FROM	TO	SIZE	PUT IN	PULLED OUT
				8 5/8"	250	None
				4 1/2"	3974	3102

Describe in detail the manner in which the well was plugged, indicating where the mud fluid was placed and the method or methods used in introducing it into the hole. If cement or other plugs were used, state the character of same and depth placed, from _____ feet to _____ feet for each plug set.

August 7, 1974 Plugged off bottom. Dumped sand to 3800'. Mixed and dumped 4 sx of cement.
August 27, 1974 Plugged off top. Sun Oil Well Cementing Co. mixed and pumped down 8 5/8" surface casing; 2 sx of hulls, 10 sx of gel and 100 sx of cement.

RECEIVED
STATE CORPORATION COMMISSION
SEP 12 1974
CONSERVATION DIVISION
Wichita, Kansas
9-12-74


(If additional description is necessary, use BACK of this sheet)
Name of Plugging Contractor RUSS CASING PULLING, INC.
Address P. O. Box 1082 ; Great Bend, Kansas 67530

STATE OF Okla, COUNTY OF Okla, ss.

C. F. Beck (employee of owner) or (owner or operator) of the above-described well, being first duly sworn on oath, says: That I have knowledge of the facts, statements, and matters herein contained and the log of the above-described well as filed and that the same are true and correct. So help me God.

(Signature) [Signature]
630 United Founders Life Tower Okla City Okla 73112
(Address)

Subscribed and sworn to before me this 11th day of September, 1974

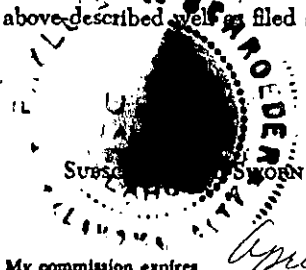

[Signature]
Notary Public.

ALKAY ROYALTIES
No. 1 Southards
C SE SE, Sec. 29-25S-14W
Stafford County, Kansas

DRILLERS LOG

Commenced: 11-5-73
Completed: 11-15-73

Elevation: 2004 K.B.

Surface Casing: 284.38' of
8-5/8" cemented w/250 sx
cement, 38 cc. 11-5-73

<u>FORMATION</u>	<u>DEPTH</u>
Surface Hole	0 - 292
Shale	292 - 920
Anhydrite	920 - 935
Shale & Shells	935 - 1850
Lime & Shale	1850 - 2030
Shale, Sand & Lime	2030 - 2198
Shale & Lime	2198 - 2390
Lime & Shale	2390 - 2690
Shale & Lime	2690 - 2870
Sand & Shale	2870 - 2940
Shale & Sand	2940 - 2980
Shale & Lime	2980 - 3125
Lime & Shale	3125 - 3974 T.D.

RECEIVED
STATE CORPORATION COMMISSION
AUG 13 1974
CONSERVATION DIVISION
Wichita, Kansas

I do hereby certify that the foregoing statements are true and correct to the best of my knowledge and belief.

D N B DRILLING, INC.

James L. Donelson
JAMES L. DONELSON

STATE OF KANSAS: ss:

Subscribed and sworn to before me, the undersigned, a Notary Public in and for said state, this 16th day of November, 1973.

My Commission Expires:
August 25, 1976

Ella Pries
Ella Pries, Notary Public

Ella Pries
STATE NOTARY PUBLIC
Sedgwick County, Kansas
My Com. Expires Aug. 25, 1976