


STATE OF KANSAS  
STATE CORPORATION COMMISSION

WELL PLUGGING RECORD

Give All Information Completely  
Make Required Affidavit  
Mail or Deliver Report to:  
Conservation Division  
State Corporation Commission  
211 N. Broadway  
Wichita, Kansas

Reno County. Sec. 9 Twp. 24S Rge. 10W (E) (W)  
Location as "NE/CNW/SW" or footage from lines SE SE NW  
Lease Owner Anschutz Drilling Co., Inc.  
Lease Name Waggener Well No. 1  
Office Address 709 Union Natl. Bldg., Wichita, Kansas  
Character of Well (completed as Oil, Gas or Dry Hole) Dry  
Date well completed October 1 1956  
Application for plugging filed October 1 1956  
Application for plugging approved October 1 1956  
Plugging commenced October 1 1956  
Plugging completed October 1 1956  
Reason for abandonment of well or producing formation Dry

NORTH

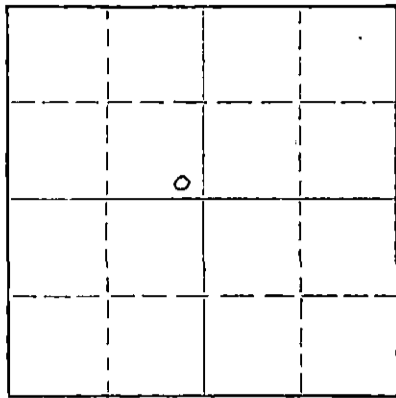

Locate well correctly on above  
Section Plat

If a producing well is abandoned, date of last production \_\_\_\_\_ 19\_\_\_\_  
Was permission obtained from the Conservation Division or its agents before plugging was commenced? Yes

Name of Conservation Agent who supervised plugging of this well Ruel Durkee  
Producing formation \_\_\_\_\_ Depth to top \_\_\_\_\_ Bottom \_\_\_\_\_ Total Depth of Well 4090 Feet  
Show depth and thickness of all water, oil and gas formations.

OIL, GAS OR WATER RECORDS

CASING RECORD

FORMATION	CONTENT	FROM	TO	SIZE	PUT IN	PULLED OUT
				8-5/8"	223'	

Describe in detail the manner in which the well was plugged, indicating where the mud fluid was placed and the method or methods used in introducing it into the hole. If cement or other plugs were used, state the character of same and depth placed, from \_\_\_\_\_ feet to \_\_\_\_\_ feet for each plug set.

Filled hole to 210' with heavy mud.  
Drove bottom plug to 210' and cemented with 15 sacks cement.  
Drove top plug to 25' and cemented with 10 sacks cement.

10-6-56  
CONSERVATION DIVISION  
Wichita, Kansas

(If additional description is necessary, use BACK of this sheet)  
Name of Plugging Contractor Anschutz Drilling Co., Inc.  
Address 709 Union Natl. Bldg., Wichita, Kansas

STATE OF Kansas, COUNTY OF Sedgwick, ss.  
Shirley Salley (employee of owner) or (owner or operator) of the above-described well, being first duly sworn on oath, says: That I have knowledge of the facts, statements, and matters herein contained and the log of the above-described well as filed and that the same are true and correct. So help me God.

(Signature) Shirley Salley  
709 Union Natl. Bldg., Wichita, Kansas  
(Address)

SUBSCRIBED AND SWORN to before me this 1st day of October, 1956  
Kenneth R. Swenson  
Kenneth R. Swenson Notary Public.

My commission expires April 27, 1959

PLUGGING  
FILE SEC 89124 10W  
BOOK PAGE 105 LINE 28

D R I L L E R S ' L O G

ANSCHUTZ DRILLING CO., INC.  
#1 WAGGENER  
SE SE NW Sec. 9-24S-10W  
Reno County, Kansas

FROM	TO	
0	128	Soil and sand
128	150	Shale and shells
150	440	Red rock
440	475	Anhydrite
475	1355	Shale and shells
1355	1545	Shale and lime
1545	1715	Lime
1715	1995	Lime and shale
1995	2160	Shale
2160	2315	Shale with lime
2315	2705	Shale
2705	2880	Shale and lime
2880	3235	Lime
3235	3270	Lime and shale
3270	3295	Lime
3295	3350	Shale and lime
3350	3716	Lime
3716	3773	Mississippi and Kinderhook
3773	3876	Lime and shale
3876	3879	Viola
3879	3921	Cherty Viola
3921	3949	Lime
3949	4050	Lime and shale
4050	4090	Arbuckle
	4090	Total Depth

COMMENCED: 9/17/56  
COMPLETED: 10/1/56

CASING RECORD:  
Set 223' of 8-5/8" surface casing with 175 sacks cement, 200# gel., 200# calcium chloride

1772 eb

STATE OF KANSAS )  
                          ) SS  
COUNTY OF SEDGWICK )

I hereby affirm that the above and foregoing is a true and correct copy of the formations encountered on the #1 Waggener, SE SE NW of Section 9-24S-10W, Reno County, Kansas, as reflected by the daily drilling reports.

ANSCHUTZ DRILLING CO., INC.

STATE COMMISSIONER OF CONSERVATION By: *Shirley Salley*  
OCT 6 1956 Shirley Salley

CONSERVATION DIVISION  
Wichita, Kansas 10-6-56

Subscribed and sworn to before me this 4th day of October, 1956.

My Commission Expires: April 27, 1959

*Kenneth R. Swenson*  
Kenneth R. Swenson, Notary Public

PLUGGING  
FILE SEC 29 24 ROW  
BOOK PAGE 105 LINE 28