


STATE OF KANSAS
STATE CORPORATION COMMISSION

Form CP-4

Give All Information Completely
Make Required Affidavit
Mail or Deliver Report to:
Conservation Division
State Corporation Commission
211 No. Broadway
Wichita, Kansas

WELL PLUGGING RECORD

NORTH

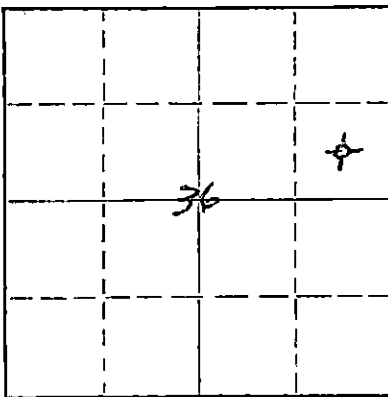

Locate well correctly on above
Section Plat

Reno County, Sec. 36 Twp. 24 Rge. (E) 9 (W)
Location as "NE/CNW/SW" or footage from lines C SE NE
Lease Owner High Plains Production, Co.
Lease Name Kanatzer Well No. 1
Office Address 300 Insurance Bldg., Wichita, Kansas
Character of Well (completed as Oil, Gas or Dry Hole) dry hole
Date well completed 12-11-63 19
Application for plugging filed 12-16-63 19
Application for plugging approved 19
Plugging commenced 7:30, a.m. 12-11-63 19
Plugging completed 12:00, 12-11-63 19
Reason for abandonment of well or producing formation dry hole

If a producing well is abandoned, date of last production 19
Was permission obtained from the Conservation Division or its agents before plugging was commenced? yes

Name of Conservation Agent who supervised plugging of this well Gilbert Tomán
Producing formation Depth to top Bottom Total Depth of Well Feet
Show depth and thickness of all water, oil and gas formations.

OIL, GAS OR WATER RECORDS

CASING RECORD

FORMATION	CONTENT	FROM	TO	SIZE	PUT IN	PULLED OUT
		0'	196'	8 5/8"	196	none

Describe in detail the manner in which the well was plugged, indicating where the mud fluid was placed and the method or methods used in introducing it into the hole. If cement or other plugs were used, state the character of same and depth placed, from feet to feet for each plug set.

Bottom plug at 190' w/ 1/4 sack hulls and 20 sack cement.

Top plug @ 40' with 1/2 sack hulls and 10 sack cement.

2 sack cement in rat hole.

RECEIVED
STATE CORPORATION COMMISSION

DEC 17 1963

12-17-63

CONSERVATION DIVISION
Wichita, Kansas

(If additional description is necessary, use BACK of this sheet)

Name of Plugging Contractor Vaughan Drilling, Inc.
Address Box 825, Great Bend, Kansas

STATE OF Kansas, COUNTY OF Barton, ss.

Donald D. Vaughan (employee of owner) or (owner or operator) of the above-described well, being first duly sworn on oath, says: That I have knowledge of the facts, statements, and matters herein contained and the log of the above-described well as filed and that the same are true and correct. So help me God.

(Signature)

Box 825, Great Bend, Kansas

(Address)

SUBSCRIBED AND SWORN TO before me this 16th day of December, 1963

My commission expires Oct. 4, 1966

Kathryn M. Boxberger, Notary Public.

WELL LOG

COMPANY	High Plains Production Co.
CONTRACTOR	Vaughan Drilling, Inc.
FARM	#1 Kanatzer
LOCATION	C SE NE Section 36-24S-9W
	Reno County, Kansas
ELEVATION	1664' K. B.
SURFACE PIPE	8 5/8" cemented @ 196' with 150 sax Posmix Sunset.
PRODUCTION	D & A.
COMMENCED	12-2-63
COMPLETED	12-11-63

<u>FORMATION</u>	<u>DEPTH</u>
Sandstone	85
Red Bed with Sand Streak	196
Red Bed & Shale	280
Red Bed & Green Shale	645
Anhydrite	648
Shale & Shells	1375
Limestone & Shale	2178
Shale & Shells	2490
Limestone & Shale	2910
Limestone	3035
Limestone & Shale	3275
Limestone	3680
Limestone & Shale	3745
Limestone	3805
Chert	3815
Limestone	3845

RECEIVED
STATE CORPORATION COMMISSION
DEC 17 1963
12-17-63
CONSERVATION DIVISION
Wichita, Kansas

FORMATION TOPS

Heebner	3085 (-1421)
Toronto	3099 (-1435)
Lansing	3303 (-1639)
Base Kansas City	3660 (-1996)
Mississippi	3794 (-2130)
RTD	3845 (-2181)

A F F I D A V I T

STATE OF KANSAS, COUNTY OF BARTON, SS

I, Donald D. Vaughan, of the Vaughan Drilling, Inc., being first duly sworn on oath, state; that I have knowledge of the facts, statements and matters herein contained and that the same are true and correct.

Donald D. Vaughan
Donald D. Vaughan

Subscribed and sworn to before me this 13th day of December, 1963.

Kathryn M. Boxberger
Kathryn M. Boxberger, Notary Public

My Commission expires: Oct. 4, 1966.