


WELL PLUGGING RECORD

Give All Information Completely
Make Required Affidavit
Mail or Deliver Report to:
Conservation Division
State Corporation Commission
212 No. Market
Wichita, Kansas

Reno County, Sec. 15 Twp. 24S Rge. (X) 9 (W)

Location as "NE/CNW/SW" or footage from lines C SW NW
Lease Owner Sierra Petroleum Co., Inc.
Lease Name Dion Well No. 1
Office Address 211 North Broadway, Wichita, Kansas
Character of Well (completed as Oil, Gas or Dry Hole) Dry Hole
Date well completed October 1, 19 66
Application for plugging filed October 1, 19 66
Application for plugging approved October 1, 19 66
Plugging commenced October 1, 19 66
Plugging completed October 1, 19 66
Reason for abandonment of well or producing formation

NORTH

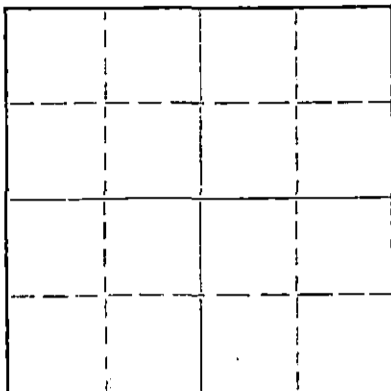

Locate well correctly on above Section Plat

If a producing well is abandoned, date of last production 19

Was permission obtained from the Conservation Division or its agents before plugging was commenced? Yes

Name of Conservation Agent who supervised plugging of this well Gilbert J. Toman, Holyrood, Kansas

Producing formation Depth to top Bottom Total Depth of Well 3825 Feet

Show depth and thickness of all water, oil and gas formations.

OIL, GAS OR WATER RECORDS

CASING RECORD

FORMATION	CONTENT	FROM	TO	SIZE	PUT IN	PULLED OUT
				8-5/8"	210'	None

Describe in detail the manner in which the well was plugged, indicating where the mud fluid was placed and the method or methods used in introducing it into the hole. If cement or other plugs were used, state the character of same and depth placed, from feet to feet for each plug set.

Mudded up with heavy mud to 210 feet. Followed by wooden plug and 1/2 sack hulls. Placed 25 sacks cement onto hulls. Mudded up with heavy mud to 40 feet followed by wooden plug, 1/4 sack hulls and 10 sacks cement to base of well cellar. Plugged rat hole with 2 sacks cement.

RECEIVED
STATE CORPORATION COMMISSION
OCT 13 1966
CONSERVATION DIVISION
Wichita, Kansas

10-12-66

(If additional description is necessary, use BACK of this sheet)

Name of Plugging Contractor Graves Drilling Co., Inc.
Address 412 Union Center, Wichita, Kansas

STATE OF KANSAS COUNTY OF BUTLER ss.

John C. Graves (employee of owner) or (owner or operator) of the above-described well, being first duly sworn on oath, says: That I have knowledge of the facts, statements, and matters herein contained and the log of the above-described well as filed and that the same are true and correct. So help me God.

(Signature) John C. Graves
412 Union Center, Wichita, Kansas 67202
(Address)

SUBSCRIBED AND SWORN TO before me this 5th day of October, 19 66

My commission expires April 30, 1967 Betty Brandt Notary Public.

R O T A R Y D R I L L E R S ' L O G

OPERATOR: Sierra Petroleum Co., Inc. DRILLING COMMENCED: September 24, 1966
211 North Broadway
Wichita, Kansas

CONTRACTOR: Graves Drilling Co., Inc. DRILLING COMPLETED: October 1, 1966
412 Union Center
Wichita, Kansas

CASING RECORD: 6 Jts. 210' 8-5/8" LOCATION: Dion No. 1
cemented with 200 sacks C SW NW
Section 15-24S-9W
Reno County, Kansas

0 - 216	Soil, sand & red bed
216 - 505	Sand & shale
505 - 1234	Shale & shells
1234 - 1335	Shale & Anhydrite strings
1335 - 2822	Lime & shale
2822 - 3123	Lime
3123 - 3318	Shale & lime
3318 - 3825	Lime
3825	Rotary Total Depth

RECEIVED
STATE CORPORATION COMMISSION
OCT 12 1966
CONSERVATION DIVISION
Wichita, Kansas
10-12-66

I hereby certify the foregoing statements to be true and correct to the best of my knowledge.

GRAVES DRILLING CO., INC.

By Phil Graves

STATE OF KANSAS)
) SS:
BUTLER COUNTY)

Subscribed and sworn to before me, a Notary Public, this 5th of October, 1966.

Betty Brandt
Betty Brandt Notary Public

My commission expires:
April 30, 1967