


STATE OF KANSAS
STATE CORPORATION COMMISSION

WELL PLUGGING RECORD

Give All Information Completely
Make Required Affidavit
Mail or Deliver Report to
Conservation Division
State Corporation Comm.
245 North Water
Wichita, KS 67202

Reno County. Sec. 16 Twp. 24 Rge. 9 E/W
Location as "NE/CNW $\frac{1}{4}$ SW $\frac{1}{4}$ " or footage from lines
NE-NE-NE
Lease Owner National Crude, Inc.
Lease Name Plevna Town Sight Well No. 1
Office Address 7701 E. Kellogg Wichita, Kans. 67207
Character of Well (Completed as Oil, Gas or Dry Hole)
dry hole
Date Well completed 5-26-77 19
Application for plugging filed 5-26-77 19
Application for plugging approved. 5-26-77 19
Plugging commenced 12:15 AM 5-27-77 19
Plugging completed 12:50 AM 5-27-77 19
Reason for abandonment of well or producing formation
dry

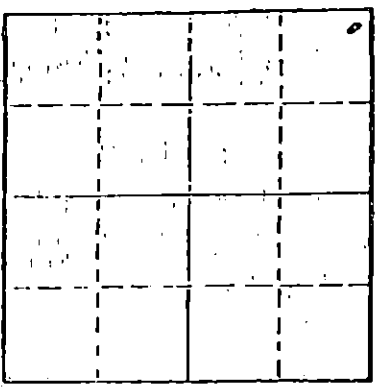

Locate well correctly on above
Section Plat

If a producing well is abandoned, date of last production
19
Was permission obtained from the Conservation Division or
its agents before plugging was commenced? yes

Name of Conservation Agent who supervised plugging of this well Bud Metz
Producing formation _____ Depth to top _____ Bottom _____ Total Depth of Well 3800'
Show depth and thickness of all water, oil and gas formations.

OIL, GAS OR WATER RECORDS

CASING RECORD

FORMATION	CONTENT	FROM	TO	SIZE	PUT IN	PULLED OUT

Describe in detail the manner in which the well was plugged, indicating where the mud fluid was placed and the method or methods used in introducing it into the hold. If cement or other plugs were used, state the character of same and depth placed, from _____ feet to _____ feet for each plug set.

Bottom Plug at 240' W/35 sacks 50/50 Pozmix
Top Plug at 40' W/1/2 sack hulls & 10 sacks cement
5 sacks in rat hole

(If additional description is necessary, use BACK of this sheet)

Name of Plugging Contractor _____

STATE OF Kansas COUNTY OF Barton, ss.

Wayne Dobbs (employee of owner) or (~~owner~~)
of the above-described well, being first duly sworn on oath, says: That I have knowledge of the facts, statements, and matters herein contained and the log of the above-described well as filed and that the same are true and correct. So help me God.

(Signature) Wayne Dobbs
Great Bend, Kansas 67530
(Address)

SUBSCRIBED AND SWORN TO before me this 27 th day of May, 1977

My commission expires 5-20-81

Bessie M. Dewerff
Bessie M. Dewerff Notary Public.
STATE CORPORATION COMMISSION

5-31-77
MAY 31 1977

BESSIE M. DEWERFF
STATE NOTARY PUBLIC
BARTON COUNTY, KANSAS
MY APPT. EXP. 5-20-81

CONSERVATION DIVISION
Wichita, Kansas

DRILLERS WELL LOG

L. D. DRILLING COMPANY - CONTRACTOR NATIONAL CRUDE, INC. - OPERATOR

PLEWNA TOWN SITE
NE-NE-NE 16-24-9
RENO COUNTY, KANSAS

T. D. 3800'
ELEV. 1691 KB

COMMENCED: 5-20-77
COMPLETED: 5-26-77

Casing:
3 5/8" set at 206'

Cement:
170 sk 60/40 Pozmix, 2% Gel, 3% CC

FORMATION

DEPTH

Clay	0 - 20
Sand	20 - 105
Red Bed	105 - 450
Shale & Shells	450 - 1400
Lime & Shale	1400 - 3103
Shale	3103 - 3107
Lime & Shale	3107 - 3788
Chert	3788 - 3800

TOPS

Heeb.	3103
Toronto	3119
Douglas	3130
Brn. Lime	3288
Lansing	3312
Base K.C.	3668
Miss.	3788
TD	3800

AFFIDAVIT

State of Kansas, County of Barton

I, Wayne Dobbs of the L. D. DRILLING COMPANY

being first duly sworn on oath, state: That I have knowledge of the facts, statements and matters herein contained and that the same are true and correct.

Wayne Dobbs
Wayne Dobbs

Subscribed and sworn to before me on this 27th day of May 1977

My commission Expires:

Bessie M. Dewerff
Notary Public: Bessie M. Dewerff

BESSIE M. DEWERFF
STATE NOTARY PUBLIC
BARTON COUNTY, KANSAS
MY APPT. EXP. 5-20-81

RECEIVED
STATE CORPORATION COMMISSION
5-31-77
MAY 31 1977

CONSERVATION DIVISION
Wichita, Kansas