


STATE OF KANSAS
STATE CORPORATION COMMISSION

Give All Information Completely
Make Required Affidavit
Mail or Deliver Report to:
Conservation Division
State Corporation Commission
800 Bitting Building
Wichita, Kansas

WELL PLUGGING RECORD

Reno County. Sec. 17 Twp 24S Rge. 9 (E) W (W)
Location as "NE/CNW/SW" or footage from lines NW/4 NW/4 SW/4
Lease Owner Manhart, Millison & Beebe et al
Lease Name Hinshaw Well No. 1
Office Address 503 Jenkins Bldg., Tulsa 3, Oklahoma
Character of Well (completed as Oil, Gas or Dry Hole) Dry Hole
Date well completed September 5, 19 55
Application for plugging filed (verbal) September 5, 19 55
Application for plugging approved (verbal) September 5, 19 55
Plugging commenced September 5, 19 55
Plugging completed September 5, 19 55
Reason for abandonment of well or producing formation Dry Hole

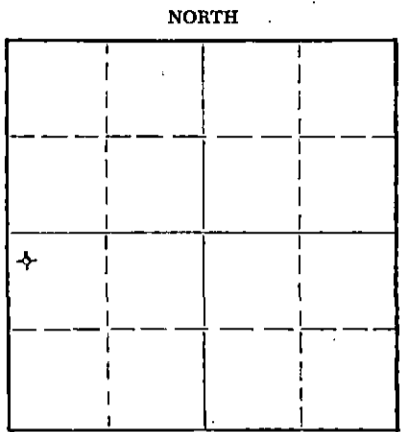

Locate well correctly on above Section Plat

If a producing well is abandoned, date of last production 19
Was permission obtained from the Conservation Division or its agents before plugging was commenced? Yes

Name of Conservation Agent who supervised plugging of this well Ruel Durkee
Producing formation Depth to top Bottom Total Depth of Well 4160 Feet
Show depth and thickness of all water, oil and gas formations.

OIL, GAS OR WATER RECORDS

CASING RECORD

| FORMATION | CONTENT | FROM | TO | SIZE | PUT IN | PULLED OUT |
|-----------|---------|------|------|--------|--------|------------|
| | | 0 | 191' | 8-5/8" | 191' | none |
| | | | | | | |
| | | | | | | |
| | | | | | | |
| | | | | | | |
| | | | | | | |
| | | | | | | |
| | | | | | | |

Describe in detail the manner in which the well was plugged, indicating where the mud fluid was placed and the method or methods used in introducing it into the hole. If cement or other plugs were used, state the character of same and depth placed, from feet to feet for each plug set.

Bottom plug set at 180' with 15 sacks cement mixed and poured through drill pipe. Top plug set at 40' with 10 sacks cement mixed and poured through pipe. Filled with mud to surface.

15-155-00288-0000
COMMISSION
1955
CONSERVATION DIVISION
9-8-55

(If additional description is necessary, use BACK of this sheet)
Name of Plugging Contractor Birmingham-Bartlett Drilling Co.
Address 300 Kaufman Building, Wichita 2, Kansas

STATE OF Kansas COUNTY OF Sedgwick
Richard Hindery, partner of Birmingham-Bartlett Drilling Co., contractor for
well, being first duly sworn on oath, says: That I have knowledge of the facts, statements, and matters herein contained and the log of the above-described well as filed and that the same are true and correct. So help me God.

(Signature) Richard Hindery
300 Kaufman Building, Wichita, Kansas
(Address)

SUBSCRIBED AND SWORN TO before me this 6th day of September, 19 55

My commission expires October 2, 1958
Beverly Larson Notary Public.

PLUGGING
FILE SEC 17 T 24 R 9 W
BOOK PAGE 147 LINE 39

HINSHAW NO. 1 WELL

LOCATION: NW/4 NW/4 SW/4
Section 17-24S-9W
Reno County, Kansas

SPUDED: 8-23-55
COMPLETED: 9-4-55

CONTRACTOR: Manhart, Millison & Beebe
503 Jenkins Building
Tulsa 3, Oklahoma

CONTRACTEE: Birmingham-Bartlett Drilling Co.
300 Kaufman Building
Wichita 2, Kansas

SURFACE CASING: 8-5/8" 24# casing cemented at 191'
with 200 sacks cement and 3 cc.

OIL STRING: None set. Dry and Abandoned.
Plugged 9-5-55.

LOG

(Figures indicate bottom of formation)

| | | |
|---|------|--------------------|
| 0 | 70 | Clay and sand |
| | 130 | Red bed and shells |
| | 191 | Red bed |
| | 710 | Red bed and shells |
| | 1180 | Shale |
| | 1340 | Shale and shells |
| | 2540 | Lime and shale |
| | 2705 | Shale and shells |
| | 3310 | Shale and lime |
| | 3786 | Lime |
| | 3855 | Shale |
| | 3925 | Shale and shells |
| | 3989 | Shale and lime |
| | 4062 | Lime |
| | 4100 | Lime and sand |
| | 4145 | Shale and sand |
| | 4160 | Lime |
| | 4160 | Rotary Total Depth |

The undersigned, Richard Hindery, one of the partners of Birmingham-Bartlett Drilling Co., hereby certifies that the above is a true and correct log of the formations encountered in drilling the Hinshaw No. 1 Well as shown in the daily drilling reports.

BIRMINGHAM-BARTLETT DRILLING CO.

By Richard Hindery

Subscribed and sworn to before me
this 6th day of September, 1955.

Beverly Larson
Notary Public

My commission expires October 2, 1958.

