

STATE OF KANSAS  
STATE CORPORATION COMMISSION


Form CP-4

WELL PLUGGING RECORD

Give All Information Completely  
Make Required Affidavit  
Mail or Deliver Report to:  
Conservation Division  
State Corporation Commission  
211 No. Broadway  
Wichita, Kansas

Edwards County, Sec. 10 Twp. 26S Rge. (E) 20 (W)  
Location as "NE/CNW%SW%" or footage from lines C NW NW NE  
Lease Owner Rains & Williamson Oil Co.  
Lease Name LEWIS Well No. 1  
Office Address 1425 Wichita Plaza, Wichita, Kansas  
Character of Well (completed as Oil, Gas or Dry Hole) Dry Hole  
Date well completed April 14 19 64  
Application for plugging filed April 14 19 64  
Application for plugging approved April 14 19 64  
Plugging commenced April 14 19 64  
Plugging completed April 14 19 64  
Reason for abandonment of well or producing formation No oil or gas found  
in commercial quantities.  
If a producing well is abandoned, date of last production - - 19 - -  
Was permission obtained from the Conservation Division or its agents before plugging was commenced? Yes

NORTH

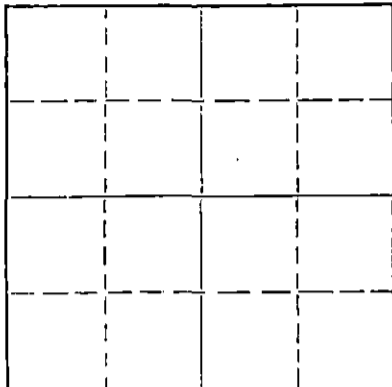

Locate well correctly on above  
Section Plat

Name of Conservation Agent who supervised plugging of this well Archie Elving, Pratt, Kansas  
Producing formation \_\_\_\_\_ Depth to top \_\_\_\_\_ Bottom \_\_\_\_\_ Total Depth of Well 4890 Feet  
Show depth and thickness of all water, oil and gas formations.

OIL, GAS OR WATER RECORDS

CASING RECORD

FORMATION	CONTENT	FROM	TO	SIZE	PUT IN	PULLED OUT
				8-5/8"	320	None

Describe in detail the manner in which the well was plugged, indicating where the mud fluid was placed and the method or methods used in introducing it into the hole. If cement or other plugs were used, state the character of same and depth placed, from \_\_\_\_\_ feet to \_\_\_\_\_ feet for each plug set.

Set plug and hulls at 300' with 25 sacks cement through drill pipe.  
Filled hole with rotary mud to 40' of base of cellar. Set solid  
bridge and capped with 10 sacks cement.

RECEIVED  
STATE CORPORATION COMMISSION

APR 16 1964

4-16-64  
CONSERVATION DIVISION  
Wichita, Kansas

(If additional description is necessary, use BACK of this sheet)

Name of Plugging Contractor Rains & Williamson Oil Co.  
Address 1425 Wichita Plaza, Wichita, Kansas

STATE OF Kansas, COUNTY OF Sedgwick, ss.  
Wilson Rains ~~X COPY X COPY X COPY~~ (owner or operator) of the above-described well, being first duly sworn on oath, says: That I have knowledge of the facts, statements, and matters herein contained and the log of the above-described well as filed and that the same are true and correct. So help me God.

(Signature) Wilson Rains  
Wilson Rains  
1425 Wichita Plaza, Wichita, Kansas  
(Address)

SUBSCRIBED AND SWORN TO before me this 15th day of April, 19 64

My commission expires January 8, 1968

Shirley Keck  
Notary Public.



15-047-10095-0000

Operator: Rains & Williamson Oil Co. Contractor: Rains & Williamson  
No. 1 LEWIS Oil Co.  
C NW NW NE Sec. 10-26S--20W Commenced: 3-30-64  
Edwards County, Kansas Completed: 4-14-64

Remarks: Set 320' 8-5/8" surface casing with 225 sacks cement.

FORMATIONS

Sand	120'
Shale	550'
Sand	580'
Shale & Red Bed	700'
Anhydrite	715'
Shale & Red Bed	970'
Shale	1270'
Anhydrite	1320'
Shale	1515'
Shale & Shells	2045'
Lime & Shale	2160'
Shale & Lime	2250'
Lime & Shale	3375'
Shale & Lime	3840'
Lime & Shale	3920'
Lime	4010'
Lime & Shale	4105'
Lime	4730'
Lime & Shale	4750'
Chert & Lime	4765'
Lime	4809'
Lime & Shale & Chert	4890'
Rotary Total Depth	4890'

RECEIVED  
STATE CORPORATION COMMISSION

APR 16 1964

CONSERVATION DIVISION  
Wichita, Kansas

We certify the above log is true and correct to the best of our knowledge and belief.

RAINS & WILLIAMSON OIL CO.

*Wilson Rains*  
Wilson Rains, Partner

Subscribed and sworn to before me, a Notary Public in and for the State of Kansas, County of Sedgwick, this 15th day of April, 1964.

My Commission Expires:  
January 8, 1968

*Shirley Keck*  
Shirley Keck, Notary Public