


WELL PLUGGING RECORD 15-047-652412-0000

Give All Information Completely
Make Required Affidavit
Mail or Deliver Report to:
Conservation Division
State Corporation Commission
212 North Market, Insurance Bldg.
Wichita, Kansas

Edwards County. Sec. 18 Twp. 26S Rge. 20W (E) (W)
Location as "NE/CNW/SW" or footage from lines 330' F/West & 660' F/North Line (NW/4)
Lease Owner Sinclair Oil & Gas Company
Lease Name H. Quasebarth Well No. 1
Office Address P. O. Box 521, Tulsa 2, Oklahoma
Character of Well (completed as Oil, Gas or Dry Hole) Dry Hole
Date well completed April 21, 19 62
Application for plugging filed May 2, 19 62
Application for plugging approved April 21, 1962 19
Plugging commenced April 20, 19 62
Plugging completed April 21, 19 62
Reason for abandonment of well or producing formation Dry Hole

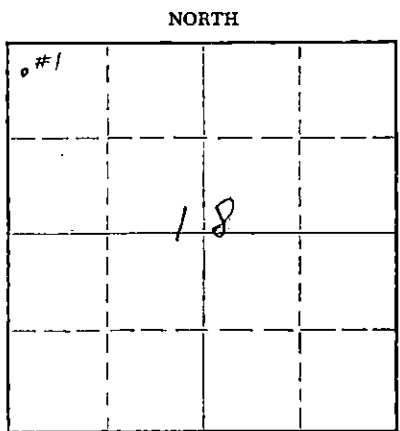

Locate well correctly on above Section Flat

If a producing well is abandoned, date of last production _____ 19____
Was permission obtained from the Conservation Division or its agents before plugging was commenced? Yes

Name of Conservation Agent who supervised plugging of this well W. L. LaKamp
Producing formation None Depth to top _____ Bottom _____ Total Depth of Well 4910 Feet
Show depth and thickness of all water, oil and gas formations.

OIL, GAS OR WATER RECORDS

CASING RECORD

FORMATION	CONTENT	FROM	TO	SIZE	PUT IN	PULLED OUT
<u>None Encountered</u>				<u>8 5/8"</u>	<u>398'</u>	<u>None</u>

Describe in detail the manner in which the well was plugged, indicating where the mud fluid was placed and the method or methods used in introducing it into the hole. If cement or other plugs were used, state the character of same and depth placed, from _____ feet to _____ feet for each plug set.

Mudded hole from 4910' to 350'. Spotted 25 sacks cement 350', Cement top 300'. Mudded from 300' to 30'. Cemented from 30' to surface w/15 sacks cement cap. Completed P&A as directed by Mr. W. L. LaKamp, State Plugging Inspector.

RECEIVED
STATE CORPORATION COMMISSION
MAY 15 1962
5-15-62
CONSERVATION DIVISION
Wichita, Kansas

(If additional description is necessary, use BACK of this sheet)
Name of Plugging Contractor Barbour Drilling Company
Address P. O. Box 3806, Tulsa 9, Oklahoma

STATE OF KANSAS COUNTY OF Rice, ss.
G. E. Most (employee of owner) or (owner or operator) of the above-described well, being first duly sworn on oath, says: That I have knowledge of the facts, statements, and matters herein contained and the log of the above-described well as filed and that the same are true and correct. So help me God.

(Signature) G. E. Most
P. O. Box 466, Chase, Kansas
(Address)

SUBSCRIBED AND SWORN TO before me this 2 day of May, 1962
S. B. Reynolds
Notary Public.

My commission expires 8-13-62

H. QUASEBARTH NO. 1

NW/4 Section 18-26S-20W
 Edwards County, Kansas
 Sinclair Oil & Gas Company

15-047-00242-0000

8-5/8" O. D. casing cemented at 400'

Drilling commenced 3-29-62
 Drilling completed 4-21-62

FROM	TO	FORMATION	REMARKS
0'	60'	Clay & sand	
60	155	Sand	
155	285	Shale & shells	
285	400	Shale & lime	8-5/8" O. D. casing cemented with 250 sacks @ 400'
400	525	Shale	
525	1295	Red bed	
1295	1325	Anhydrite	
1325	1620	Shale, shells & salt	
1620	2290	Shale & lime	
2290	2300	Lime & shale	
2300	2365	Anhydrite & shale	
2365	2430	Shale & lime	
2430	2590	Lime & shale	
2590	2630	Lime	
2630	2850	Lime & shale	
2850	2910	Lime	
2910	3230	Shale & lime	
3230	3275	Lime & shale	
3275	3345	Shale & sand	
3345	3395	Shale	
3395	3460	Shale & lime	
3460	3525	Lime & shale	
3525	3595	Shale & lime	
3595	4070	Lime	
4070	4140	Shale & lime	
4140	4640	Lime	
4640	4720	Lime & shale	
4720	4770	Shale	
4770	4895	Lime	
4895	4910	Cherty lime	Well plugged

RECEIVED
 STATE CORPORATION COMMISSION
 MAY 15 1962
 CONSERVATION DIVISION
 Wichita, Kansas

T. D. 4910'

This is a true copy of the driller's log as shown on the drilling tickets.

BARBOUR DRILLING COMPANY

BY: *E. W. Driby*

Subscribed and sworn to before me on this 30th day of April, 1962.

Merry Jane Burt
 Notary Public

My commission expires 7-27-65