

STATE OF KANSAS  
STATE CORPORATION COMMISSION

Form CP-4


Give All Information Completely  
Make Required Affidavit  
Mail or Deliver Report to:  
Conservation Division  
State Corporation Commission  
212 No. Market  
Wichita, Kansas

WELL PLUGGING RECORD

Ford County, Sec. 2 Twp. 26 Rge. 21 (E) (W)

Location as "NE/CNW/SW" or footage from lines. C SW SW  
Lease Owner Mull Drilling Company, Inc.  
Lease Name Wetzel Well No. 1  
Office Address 1625 Wichita Plaza Building Wichita, Kansas 67210  
Character of Well (completed as Oil, Gas or Dry Hole)  
Date well completed 19  
Application for plugging filed 9-8-66 19  
Application for plugging approved 9-9-66 19  
Plugging commenced 9-14-66 19  
Plugging completed 9-20-66 19  
Reason for abandonment of well or producing formation

NORTH

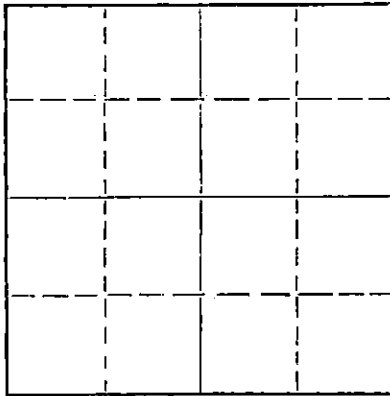

Locate well correctly on above  
Section Plat

If a producing well is abandoned, date of last production 19  
Was permission obtained from the Conservation Division or its agents before plugging was commenced? Yes

Name of Conservation Agent who supervised plugging of this well Edgar J. Eves  
Producing formation Depth to top Bottom Total Depth of Well PBL815 Feet  
Show depth and thickness of all water, oil and gas formations.

OIL, GAS OR WATER RECORDS

CASING RECORD

FORMATION	CONTENT	FROM	TO	SIZE	PUT IN	PULLED OUT
		STATE CORPORATION COMMISSION	STATE CORPORATION COMMISSION	2 1/2	287	None
				2	None	3026
		SEP 29 1966				
		9-29-66				
		CONSERVATION DIVISION				
		Wichita, Kansas				

Describe in detail the manner in which the well was plugged, indicating where the mud fluid was placed and the method or methods used in introducing it into the hole. If cement or other plugs were used, state the character of same and depth placed, from feet to feet for each plug set.

Moved in. Cleaned out cellar.

Sanding well - bridge at 1750'. Working pipe. Spud on bridge.

Spudded out bridge. Working pipe. Shot pipe at 4200' - 4100' and 4000'.

Working pipe. Shot pipe at 3600' - 3500' - 3400' - 3300' - 3200' - 3100' and 3015'.

Working pipe. Pulling pipe.

Pulling pipe. Mixed and pumped 20 sacks of mud. Pumped 25 sacks of cement at 700'. Pumped 20 sacks at 280'. Capped well with 15 sacks of cement.

Cleaned and doped collar threads. Well completed.

(If additional description is necessary, use BACK of this sheet)

Name of Plugging Contractor Forbes Casing Pulling, Inc.  
Address P. O. Box 221 Great Bend, Kansas

STATE OF Kansas, COUNTY OF Barton, ss.

J. O. Forbes (employee of owner) or (owner or operator) of the above-described well, being first duly sworn on oath, says: That I have knowledge of the facts, statements, and matters herein contained and the log of the above-described well as filed and that the same are true and correct. So help me God.

(Signature)

J. O. Forbes  
P. O. Box 221 Great Bend, Kansas  
(Address)

SUBSCRIBED AND SWORN TO before me this 26 day of September, 1966

My commission expires May 27, 1969

Notary Public.

ROTARY DRILLING LOG

15-057-30055-0000

OPERATOR: Mull Drilling Company, Inc. CONTRACTOR: Rains & Williamson  
 #1 WETZEL Oil Co.  
 SW SW Section 2-26S-21W COMMENCED: 11-7-65  
 Ford County, Kansas COMPLETED: 11-22-65

REMARKS: Set 285.70' of 8-5/8" surface casing with 175 sacks GL3 cement. Set 4 1/2" 1' off bottom @ 4849' with 135 sacks 60-40 posmix cement.

FORMATIONS:

Surface Clay	45'
Sand & Clay	120'
Shale	580'
Sand	625'
Shale & Red Bed	763'
Anhydrite	776'
Shale	1200'
Sand & Shale	1327'
Anhydrite	1370'
Shale	1950'
Shale & Shells	2280'
Lime & Shale	2862'
Lime	2910'
Shale & Lime	3155'
Lime & Shale	3261'
Shale & Lime	3635'
Lime & Shale	3754'
Shale & Lime	4035'
Lime & Shale	4440'
Lime	4502'
Lime & Shale	4545'
Lime	4632'
Lime & Shale	4688'
Lime	4840'
Chert & Lime	4850'
Rotary Total Depth	4850'

RECEIVED  
 STATE CORPORATION COMMISSION

OCT 5 1966

CONSERVATION DIVISION  
 Wichita, Kansas

We certify the above log is true and correct to the best of our knowledge and belief.

RAINS & WILLIAMSON OIL CO.

*Wilson Rains*  
 Wilson Rains, Partner

Subscribed and sworn to before me, a Notary Public in and for the State of Kansas, County of Sedgwick, this 29th day of November, 1965.

My Commission Expires:  
 January 8, 1968

*Shirley Keck*  
 Shirley Keck, Notary Public