


Give All Information Completely  
Make Required Affidavit  
Mail or Deliver Report to:  
Conservation Division  
State Corporation Commission  
P. O. Box 17027  
Wichita, Kansas 67217  
NORTH

WELL PLUGGING RECORD 15-057-20054-0000

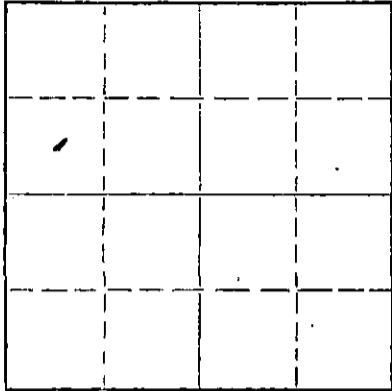

Locate well correctly on above Section Plat

Ford County, Sec. 5 Twp. 26S Rge. (E) 21W(W)  
Location as "NE/CNWxSWx" or footage from lines C SW NE  
Lease Owner OKMAR OIL COMPANY  
Lease Name Klenke Well No. 1  
Office Address 1130 Vickers/KSB&T Bldg., Wichita, Kansas  
Character of Well (completed as Oil, Gas or Dry Hole) Dry Hole  
Date well completed 8-21 1973  
Application for plugging filed 8-21 1973  
Application for plugging approved 8-21 1973  
Plugging commenced 8-21 1973  
Plugging completed 8-21 1973  
Reason for abandonment of well or producing formation No commercial quantities of oil or gas encountered.  
If a producing well is abandoned, date of last production 19  
Was permission obtained from the Conservation Division or its agents before plugging was commenced? Yes

Name of Conservation Agent who supervised plugging of this well Leo Massey  
Producing formation Depth to top Bottom Total Depth of Well 4810 Feet  
Show depth and thickness of all water, oil and gas formations.

OIL, GAS OR WATER RECORDS				CASING RECORD		
FORMATION	CONTENT	FROM	TO	SIZE	PUT IN	PULLED OUT
Surface Hole	Water	Surface	367	8-5/8"	360'	None

Describe in detail the manner in which the well was plugged, indicating where the mud fluid was placed and the method or methods used in introducing it into the hole. If cement or other plugs were used, state the character of same and depth placed, from feet to feet for each plug set.

Fluid to 660', plug, 70' sx cement;  
Fluid to 240', plug, 20' sx cement;  
Fluid to 40', plug, 1/2' sx hulls, 10' sx cement;

RECEIVED  
STATE CORPORATION COMMISSION  
AUG 22 1976  
CONSERVATION DIVISION  
Wichita, Kansas

(If additional description is necessary, use BACK of this sheet)  
Name of Plugging Contractor D N B DRILLING, INC.  
Address 701 First Nat'l Bldg., Wichita, Kansas 67202

STATE OF KANSAS, COUNTY OF \_\_\_\_\_, ss.  
JAMES L. DONELSON (employee of owner) or (owner or operator) of the above-described well, being first duly sworn on oath, says: That I have knowledge of the facts, statements, and matters herein contained and the log of the above-described well as filed and that the same are true and correct. So help me God.

(Signature) *James L. Donelson*  
701 First Nat'l Bldg., Wichita, Kansas  
(Address)

SUBSCRIBED AND SWORN TO before me this 24th day of August 19 73

*Ella Pries*  
Ella Pries Notary Public.

My commission expires August 25, 1976

1834  
STATE NOTARY PUBLIC  
Sedgwick County, Kansas  
My Com. Expires Aug. 25, 1976

DRILLERS' LOG

OKMAR OIL COMPANY  
1130 Vickers/KSB&T Bldg.  
Wichita, Kansas

No. 1 Klenke  
C SW NE, Sec. 5-26S-21W  
Ford County, Kansas

Elevation: 2332 K.B.

Commenced: 8-12-73  
Completed: 8-21-73

Surface Casing: 360' of 8-5/8"  
used casing cemented w/235 sx  
60-40 posmix, 3% cc. 8-13-83

<u>FORMATION</u>	<u>DEPTH</u>
Clay & Sand	0 - 160
Shale & Sand	160 - 820
Shale	820 - 1506
Anhydrite - Blaine	1506 - 1538
Shale	1538 - 1558
Anhydrite - Stone Corral	1558 - 1600
Shale	1600 - 2305
Lime & Shale	2305 - 4050
Lime	4050 - 4810 T.D.

RECEIVED  
STATE CORPORATION COMMISSION  
AUG 27 1973  
CONSERVATION DIVISION  
Wichita, Kansas

I do hereby certify that the foregoing statements are true and correct to the best of my knowledge and belief.

D N B DRILLING, INC.

*James L. Donelson*  
JAMES L. DONELSON

STATE OF KANSAS: ss:

Subscribed and sworn to before me, the undersigned, a Notary Public in and for said state, this 24th day of August, 1973.

My Commission Expires:  
August 25, 1976

*Ella Priess*

Ella Priess, Notary Public

*Ella Priess*  
STATE NOTARY PUBLIC  
Sedgwick County, Kansas  
My Com. Expires Aug. 25, 1976