

STATE OF KANSAS  
 STATE CORPORATION COMMISSION  
 200 Colorado Derby Bldg.  
 Wichita, Kansas 67202


Form CP-4  
 Rev. 12-15-80

15-047-21038-0000

WELL PLUGGING RECORD

Give All Information Completely  
 Make Required Affidavit

COUNTY Edwards SEC. 15 TWP. 26S RGE. 17W  W  
 Location as in quarters or footage from lines:  
E/2 E/2 NW

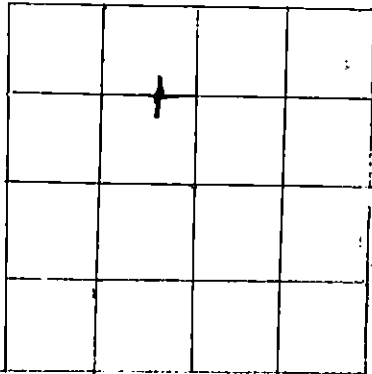

Locate Well  
 correctly on above  
 Section Platt.

Lease Owner F & M OIL CO., INC.  
 Lease Name Ary "A" Well No. 1  
 Office Address 422 Union Center, Wichita, Kansas 67202  
 Character of Well (Completed as Oil, Gas or Dry Hole): Dry  
 Date Well Completed May 11, 1982  
 Application for plugging filed May 11, 1982  
 Plugging commenced May 11, 1982  
 Plugging completed May 11, 1982  
 Reason for abandonment of well or producing formation Dry Hole

Was permission obtained from the Conservation Division or it's  
 Agent's before plugging was commenced? Yes

Name of Conservation Agent who supervised plugging of this well Paul Luthi  
 Producing formation \_\_\_\_\_ Depth to top \_\_\_\_\_ bottom T.D. 4700'  
 Show depth and thickness of all water, oil and gas formations.

OIL, GAS OR WATER RECORDS

Casing Record

Formation	Content	From	To	Size	Put in	Pulled Out

Describe in detail the manner in which the well was plugged, indicating where the mud  
 fluid was placed and the method or methods used in introducing it into the hold. If cement  
 or other plugs were used, state the character of same and depth placed, from \_\_\_\_\_ feet  
 to \_\_\_\_\_ feet for each plug set.

Set 1st plug @ 1020' w/50 sxs  
 Set 2nd plug @ 350' w/40 sxs  
 Set 3rd plug @ 40' w/10 sxs  
 10 sxs in the rat hole, plug down @ 1:15

RECEIVED  
 STATE CORPORATION COMMISSION  
 MAY 19 1982  
 CONSERVATION DIVISION  
 WICHITA, KANSAS


(If additional description is necessary, use BACK of this sheet)  
 Name of Plugging Contractor \_\_\_\_\_

STATE OF Kansas COUNTY OF Sedgwick, ss.  
R. D. Messinger (employee of owner) or (owner or operator) of the  
 above-described well, being first duly sworn on oath, says: That I have knowledge of the  
 facts, statements, and matters herein contained and the log of the above-described well as  
 filed and that the same are true and correct. So help me God.

(Signature) [Signature]  
422 Union Center, Wichita, Ks. 67202  
 (Address)

SUBSCRIBED AND SWORN TO before me this 26th day of May 19 82

[Signature]  
 Notary Public.  
 Shirley A. Gallegos

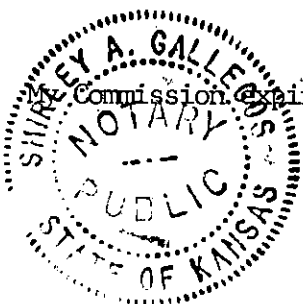

Commission Expires: 12-24-84