

STATE OF KANSAS
STATE CORPORATION COMMISSION


WELL PLUGGING RECORD

15-047-20847-0000

Give All Information Completely
Make Required Affidavit
Mail or Deliver Report to
Conservation Division
State Corporation Comm.
245 North Water
Wichita, KS 67202

Edwards County, Sec. 15 Twp. 26S Rge. 17W /E/W
Location as "NE/CNW $\frac{1}{4}$ SW $\frac{1}{4}$ " or footage from lines
100' SE of SE/4 SE/4

Lease Owner Gear Petroleum Company, Inc.
Lease Name Fisher "A" Well No. 1
Office Address 300 Sutton Place, Wichita, Kansas 67202
Character of Well (Completed as Oil, Gas or Dry Hole) D & A

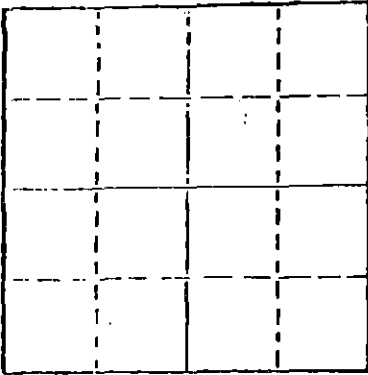

Locate well correctly on above
Section Plot

Date Well completed May 4, 1981
Application for plugging filed May 4, 1981
Application for plugging approved May 4, 1981
Plugging commenced May 4, 1981
Plugging completed May 4, 1981
Reason for abandonment of well or producing formation D & A

If a producing well is abandoned, date of last production 19

Was permission obtained from the Conservation Division or its agents before plugging was commenced? Yes

Name of Conservation Agent who supervised plugging of this well Wm. T. Owen
Producing formation _____ Depth to top _____ Bottom _____ Total Depth of Well 4,725'
Show depth and thickness of all water, oil and gas formations.

OIL, GAS OR WATER RECORDS

CASING RECORD

FORMATION	CONTENT	FROM	TO	SIZE	PUT IN	PULLED OUT
				8 5/8"	278'	-0-

Describe in detail the manner in which the well was plugged, indicating where the mud fluid was placed and the method or methods used in introducing it into the hold. If cement or other plugs were used, state the character of same and depth placed, from _____ feet to _____ feet for each plug set.

Plugged hole @ 520' w/50 sx cement
@ 280' w/40 sx cement
Bridge @ 40' w/10 sx cement
10 sx cement in rathole

(If additional description is necessary, use BACK of this sheet)

Name of Plugging Contractor Red Tiger Drilling Company
1720 KSB Building, Wichita, Kansas 67202

STATE OF Kansas COUNTY OF Sedgwick, ss. contractor
Gloria Fawcett (employee of ~~owner~~ ~~operator~~)

of the above-described well, being first duly sworn on oath, says: That I have knowledge of the facts, statements, and matters herein contained and the log of the above-described well as filed and that the same are true and correct. So help me God.

(Signature) Gloria Fawcett
1720 KSB Building, Wichita, Kansas 67202
(Address)

SUBSCRIBED AND SWORN TO before me this 12th day of May, 1981.

Joyce A. Baer
Notary Public.

My commission expires _____

RECEIVED
STATE CORPORATION COMMISSION

MAY 14 1981 5-14-81

CONSERVATION DIVISION
Wichita, Kansas



DRILLERS LOG

No. 1 Fisher "A"

CASING RECORD:	COMPANY:	Gear Petroleum Company, Inc.	DESCRIPTION:
8 5/8" @ 284' w/250 sx cement	CONTRACTOR:	Red Tiger Drilling Company	100' SE of SE/4 SE/4 Sec. 15-T26S-R17W Edwards County, Kansas
D & A	COMMENCED:	April 21, 1981	
TOTAL DEPTH: 4,725'	COMPLETED:	May 4, 1981	ELEVATION: 2,122' KB

<u>FORMATION</u>	<u>FROM</u>	<u>TO</u>	<u>REMARKS</u>
Surface Soil	0	158	
Sand & Clay	158	290	
Lime & Shale	290	1040	
Shale & Lime	1040	1580	
Lime & Shale	1580	4725	
RTD		4725	

I certify that this is a true and correct copy of the above log to the best of my knowledge.

RED TIGER DRILLING COMPANY

Gloria Fawcett

 Gloria Fawcett

Subscribed and sworn to before me this 12th day of May, 1981.

Joyce A. Baer

 Notary Public



RECEIVED
 STATE CORPORATION COMMISSION
 MAY 14 1981 5-14-81
 CONSERVATION DIVISION
 Wichita, Kansas