


WELL PLUGGING RECORD

Give All Information Completely
Made Required Affidavit
Mail or Deliver Report to:
Conservation Division
State Corporation Commission
211 No. Broadway
Wichita, Kansas

Edwards County, Sec. 15 Twp. 26S Rge. 17W (E) (W)
Location as "NE/CNWxSWx" or footage from lines NW SE SE
Lease Owner Anschutz Drilling Co., Inc.
Lease Name Fatzer Well No. 2
Office Address 709 Union Natl. Bldg., Wichita, Kansas
Character of Well (completed as Oil, Gas or Dry Hole) Dry Hole
Date well completed November 9 1956
Application for plugging filed November 9 1956
Application for plugging approved November 9 1956
Plugging commenced November 9 1956
Plugging completed November 9 1956
Reason for abandonment of well or producing formation Dry

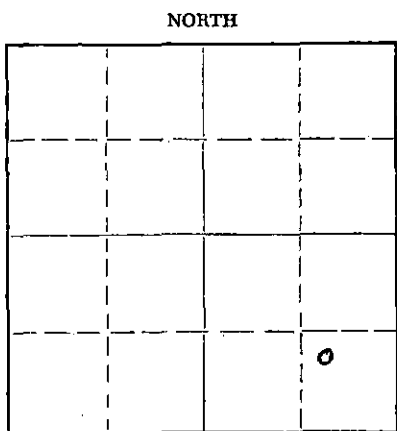

Locate well correctly on above Section Plat

If a producing well is abandoned, date of last production 19
Was permission obtained from the Conservation Division or its agents before plugging was commenced? Yes

Name of Conservation Agent who supervised plugging of this well M. A. Rives
Producing formation _____ Depth to top _____ Bottom _____ Total Depth of Well 4732 Feet
Show depth and thickness of all water, oil and gas formations.

OIL, GAS OR WATER RECORDS

CASING RECORD

FORMATION	CONTENT	FROM	TO	SIZE	PUT IN	PULLED OUT
				8-5/8"	273'	

Describe in detail the manner in which the well was plugged, indicating where the mud fluid was placed and the method or methods used in introducing it into the hole. If cement or other plugs were used, state the character of same and depth placed, from _____ feet to _____ feet for each plug set.

First plug @ 270' with 20 sacks cement.
Top plug @ 40' with 10 sacks cement.
Completed 2:00 p.m. 11/9/56.

(If additional description is necessary, use BACK of this sheet)

Name of Plugging Contractor Anschutz Drilling Co., Inc.
Address 709 Union Natl. Bldg., Wichita, Kansas

STATE OF Kansas, COUNTY OF Sedgwick, ss.
Shirley Salley (employee of owner) or (owner or operator) of the above-described well, being first duly sworn on oath, says: That I have knowledge of the facts, statements, and matters herein contained and the log of the above-described well as filed and that the same are true and correct. So help me God.

(Signature) Shirley Salley
709 Union Natl. Bldg., Wichita, Kansas
(Address)

SUBSCRIBED AND SWORN TO before me this 14th day of November, 1956

Kenneth R. Swenson
Notary Public.

My commission expires April 27, 1959

11-15-56

PLUGGING
FILE SEC. 15 T. 26 R. 17W
BOOK PAGE 115 LINE 42

DRILLERS' LOG

#2 FATZER
NW SE SE Sec. 15-26S-17W
Edwards County, Kansas

15-047-10001-0000

<u>FROM</u>	<u>TO</u>		COMMENCED: 10-25-56
0	5	Soil	
5	200	Sand	COMPLETED: 11-9-56
200	220	Shells and shale	
220	273	Blue shale and shells	CASING RECORD:
273	325	Shale	Set 273' of 8-5/8"
325	1445	Shale and red rock	surface casing with 225
1445	1600	Shale	sacks cement, 400# gel.,
1600	1750	Lime and shale	400# calcium chloride
1750	2195	Shale and lime	
2195	2410	Lime and shale	
2410	2540	Shale	
2540	2685	Lime and shale	
2685	2780	Lime	
2780	3265	Shale and lime	
3265	4170	Lime and shale	
4170	4345	Lime	
4345	4490	Lime and shale	
4490	4525	Lime and chert	
4525	4560	Mississippi lime and chert	
4560	4590	Mississippian	
4590	4643	Miss. and sand and shale	
4643	4674	Miss.	
4674	4693	Viola chert, very rough	
4693	4732	Viola	
	4732	Total Depth	

STATE OF KANSAS)
) SS
COUNTY OF SEDGWICK)

I hereby affirm that the above and foregoing is a true and correct copy of the formations encountered on the #2 Fatzer, NW SE SE of Section 15-26S-17W, Edwards County, Kansas, as reflected by the daily drilling reports.

ANSCHUTZ DRILLING CO., INC.

By: Shirley Salley
Shirley Salley

Subscribed and sworn to before me this 14th day of November, 1956.

My Commission Expires: April 27, 1959

Kenneth R. Swenson
Kenneth R. Swenson, Notary Public

PLUGGING OBSERVATION
FILE SEC. 15 T. 26 R. 17W
BOOK PAGE 115 LINE 42

NOV 15 1956
11-15-56
Wichita, Kansas