


15-047-10020-0000

WELL PLUGGING RECORD

Give All Information Completely
Make Required Affidavit
Mail or Deliver Report to:
Conservation Division
State Corporation Commission
212 North Market, Insurance Bldg.
Wichita, Kansas

NORTH

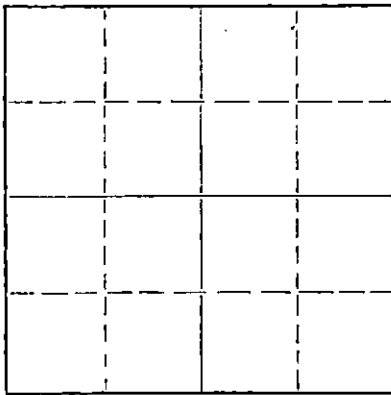

Locate well correctly on above
Section Plat

Edwards County, Sec. 14 Twp. 26 Rge. (E) 17 (W)
Location as "NE/CNW/SW" or footage from lines NE SW
Lease Owner Hudson Petroleum Company
Lease Name Carroll Well No. 1
Office Address 1112 Southwest Blvd., Kansas City, Kansas
Character of Well (completed as Oil, Gas or Dry Hole) Dry Hole
Date well completed June 9, 1959
Application for plugging filed June 9, 1959
Application for plugging approved 19
Plugging commenced June 9, 1959 19
Plugging completed June 9, 1959 19
Reason for abandonment of well or producing formation Dry Hole

If a producing well is abandoned, date of last production 19
Was permission obtained from the Conservation Division or its agents before plugging was commenced? Yes

Name of Conservation Agent who supervised plugging of this well Frank Broadfoot, St. John, Kansas
Producing formation _____ Depth to top _____ Bottom _____ Total Depth of Well 4673 Feet
Show depth and thickness of all water, oil and gas formations.

OIL, GAS OR WATER RECORDS

CASING RECORD

FORMATION	CONTENT	FROM	TO	SIZE	PUT IN	PULLED OUT
				8 5/8"	300'	None

Describe in detail the manner in which the well was plugged, indicating where the mud fluid was placed and the method or methods used in introducing it into the hole. If cement or other plugs were used, state the character of same and depth placed, from _____ feet to _____ feet for each plug set.

1/3rd Sack Hulls, Plug set @ 240', mixed 20 sacks cement through the drill pipe.
Filled hole with mud.
1/3rd Sack Hulls, Plug set @ 35', mixed 10 sacks cement through the drill pipe.

(If additional description is necessary, use BACK of this sheet)

Name of Plugging Contractor Chief Drilling Co., Inc.
Address Box 97, Great Bend, Kansas

STATE OF Kansas, COUNTY OF Wyandotte, ss.
H. C. Hopkins (employee of owner) or (owner or operator) of the above-described well, being first duly sworn on oath, says: That I have knowledge of the facts, statements, and matters herein contained and the log of the above-described well as filed and that the same are true and correct. So help me God.

(Signature) H. C. Hopkins
1112 Southwest Blvd., Kansas City, Kansas
(Address)

SUBSCRIBED AND SWORN TO before me this 12th day of June 19 59

My commission expires My Commission Expires Feb. 13, 1961

[Signature]
Notary Public.

RECEIVED
STATE CORPORATION COMMISSION

JUN 13 1959

CONSERVATION DIVISION
Wichita, Kansas

PLUGGING
FILE SEC. 14 T. 26 R. 17W
BOOK PAGE 45 LINE 8

WELL LOG

15-047-10620-0000

Hudson Petroleum Company
1112 S W Blvd. West
Kansas City, Kansas

No. 1 Carroll
NE SW Sec. 14-26-17W
Edwards County, Kansas

Contractor: Chief Drilling Co., Inc.
Rotary: 0 - 4673' T.D.

Commenced : May 26, 1959
Completed : April 9, 1959

Casing Record: 300' of 8-5/8" surface casing with 250 Common cement. Cement circulated.

<u>Formation</u>	<u>From</u>	<u>To</u>
Sand and Shale	0	297
Shale	297	348
Shale and Shells	348	410
Sand	410	435
Red Bed and Shale and Shells	435	1155
Anhydrite	1155	1160
Shale and Sand	1160	1615
Shale and Sand	1615	1620
Shale and Shells	1620	2060
Shale w/lime streaks	2060	2150
Lime and Shale	2150	2245
Lime	2245	2710
Lime and Shale	2710	3775
Lime	3775	4576
Chert	4576	4614
Lime, Sand and Chert	4614	4673 T.D.

State of Kansas)
County of Barton) /s.s.

I hereby certify that the above is a true and correct copy of the Driller's Log of the well drilled in the NE SW of Section 14, Township 26, Range 17W, Edwards, County, Kansas to the best of my knowledge and Belief.

HUDSON PETROLEUM COMPANY

E. C. Hopkins

Subscribed and sworn to before me this 12th day of June, 1959.

My Commission Expires Feb. 13, 1961.

R. L. ...

My commission expires: _____

RECEIVED
STATE CORPORATION COMMISSION

JUN 13 1959

CONSERVATION DIVISION
Wichita, Kansas

PLUGGING
FILE SEC. 14 T. 26 R. 17W
BOOK PAGE 45 LINE 8