

15-647-20033-0000


STATE OF KANSAS
STATE CORPORATION COMMISSION

Form CP-4

WELL PLUGGING RECORD

Give All Information Completely
Make Required Affidavit
Mail or Deliver Report to:
Conservation Division
State Corporation Commission
P. O. Box 17027
Wichita, Kansas 67217
NORTH

Edwards County, Sec. 9 Twp. 26 Rge. 17 (E) W (W)
Location as "NE/CNW%SW%" or footage from lines C NE SE 19 W
Lease Owner Glen Rupe
Lease Name Roenbaugh Well No. # 1
Office Address 222 Brown Bldg., Wichita, Ks. 67202
Character of Well (completed as Oil, Gas or Dry Hole) 925 O. W. Garvey Bldg., 200 W. Douglas Gas
Date well completed 8/21/ 1968
Application for plugging filed July 19 72
Application for plugging approved July 24, 19 72
Plugging commenced July 21 19 72
Plugging completed July 31 19 72
Reason for abandonment of well or producing formation depleted
"Mississippi Chert"
If a producing well is abandoned, date of last production May 23, 1972
Was permission obtained from the Conservation Division or its agents before plugging was commenced? Yes

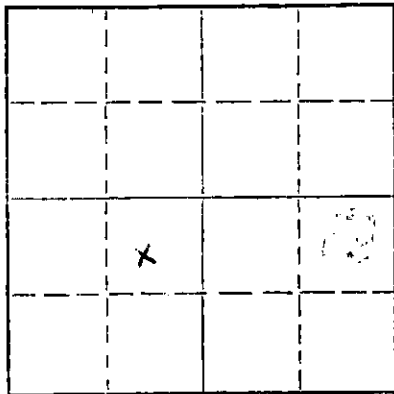

Locate well correctly on above Section Plat

Name of Conservation Agent who supervised plugging of this well Russell Biberstein
Producing formation Mississippi Chert Depth to top 4506' Bottom 4535' Total Depth of Well 4704 Feet
Show depth and thickness of all water, oil and gas formations.

OIL, GAS OR WATER RECORDS

CASING RECORD

FORMATION	CONTENT	FROM	TO	SIZE	PUT IN	PULLED OUT
				8 5/8"	249	None
				5 1/2"	4600	2200

Describe in detail the manner in which the well was plugged, indicating where the mud fluid was placed and the method or methods used in introducing it into the hole. If cement or other plugs were used, state the character of same and depth placed, from _____ feet to _____ feet for each plug set.


July 21, 1972 Plugged off bottom. Dumped sand to 3150'. Mixed and dumped 5 sx of cement.
July 31, 1972 Plugged off top. Sun Oil Well Cementing Co. mixed and pumped down 8 5/8" surface casing, 3 sx of hulls, 15 sx of gel, released plug and 100 sx of cement + 6% gel.

RECEIVED
STATE CORPORATION COMMISSION
AUG 11 1972
CONSERVATION DIVISION
Wichita, Kansas

(If additional description is necessary, use BACK of this sheet)
Name of Plugging Contractor RUSS CASING PULLING, INC.
Address P. O. Box 1082 ; Great Bend, Kansas 67530

STATE OF Kansas, COUNTY OF Sedgwick, ss.
G. N. Rupe (employee of owner or owner or operator) of the above-described well, being first duly sworn on oath, says: That I have knowledge of the facts, statements, and matters herein contained and the log of the above-described well as filed and that the same are true and correct. So help me God.

(Signature) G. N. Rupe
G. N. Rupe
925 O. W. Garvey Bldg.
200 W. Douglas, Wichita, Kansas 67202
August 19 72

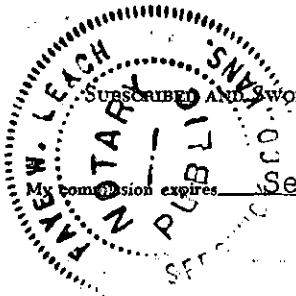

Subscribed and sworn to before me this 9th day of August, 1972
Faye W. Leach Notary Public.

DRILLER'S LOG

15-047-20033-0000

COMPANY
CONTRACTOR
FARM
LOCATION

Glen Rupe
Leben Drilling, Inc.
Roebaugh #1
C NE SE Section 9-26S-17W
Edwards County, Kansas
7-17-68
7-30-68

COMMENCED
COMPLETED

0	202	Sand
202	1187	Shale
1187	1198	Anhydrite
1198	1600	Shale, Shells
1600	2170	Shale with Streaks
2170	2348	Shale, Lime
2348	2565	Lime, Shale
2565	2935	Lime
2935	3335	Lime, Shale
3335	3656	Shale, Lime
3656	3935	Lime, Shale
3935	4095	Shale, Lime
4095	4630	Lime
4630	4659	Chert, Lime
4659	4704	Lime
	<u>4704</u>	<u>Set @ 5 1/2</u>

8 5/8" 20# New Casing Set @ 249' Cemented with 250 sacks Common
1% Gel 2% cc Cement

I, Leslie Kite, do hereby certify that the above and foregoing is
a true and correct copy of the log of the Roebaugh #1 Well, located
C NE SE of Section 9, Township 26 South, Range 17 West, Edwards
County, Kansas, as reflected by the records of Leben Drilling, Inc.

Leslie Kite

Leslie Kite

RECEIVED
STATE CORPORATION COMMISSION

JUL 24 1972

CONSERVATION DIVISION
Wichita, Kansas

STATE OF KANSAS
COUNTY OF BARTON SS

Subscribed and sworn to and before me, a Notary Public, in and
for Barton County, Kansas, this 31st day of July, 1968.

Ulanda Nichols

Ulanda Nichols

My Commission Expires:
April 1, 1971

15
FEL