

ORIGINAL KCC
SIDE ONE SEP 06

RELEASED
OCT 9 7 1992

STATE CORPORATION COMMISSION OF KANSAS
OIL & GAS CONSERVATION DIVISION
WELL COMPLETION FORM
ACO-1 WELL HISTORY
DESCRIPTION OF WELL AND LEASE

Operator: License # 5003
Name: McCoy Petroleum Corporation
Address 110 S. Main, Suite 500
Wichita, KS 67202
City/State/Zip
Purchaser: _____
Operator Contact Person: Roger McCoy
Phone (316) 265-9697
Contractor: Name: BEREDCO, Inc.
License: 5147
Wellsite Geologist: John Hastings STATE CORP. COMMISSION

Designate Type of Completion
 New Well Re-Entry Workover
 Oil SWD Temp. Abd. Inj Delayed Comp.
 Gas Inj Delayed Comp.
 Dry Other (Core, Water Supply, etc.)


If O.W.O.: old well info as follows:
Operator: _____
Well Name: _____
Comp. Date _____ Old Total Depth _____

Drilling Method:
 Mud Rotary Air Rotary Cable
8-17-91 8-24-91 8-24-91
Spud Date Date Reached TD Completion Date

API NO. 15 055-21,019-0000
CONFIDENTIAL
County Finney

C NW SE Sec. 7 Twp. 25S Rge. 32 East West
1980 Ft. North from Southeast Corner of Section
1980 Ft. West from Southeast Corner of Section
(NOTE: Locate well in section plat below.)

Lease Name Brookover Well # 1-7
Field Name Wildcat
Producing Formation _____
Elevation: Ground 2898' KB 2911'
Total Depth 5150' PBDT _____

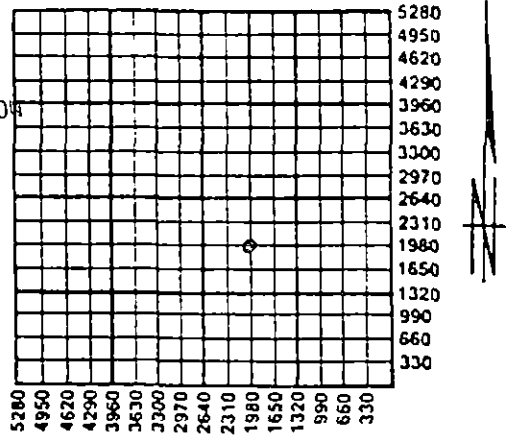

Amount of Surface Pipe Set and Cemented at 1949' Feet
Multiple Stage Cementing Collar Used? Yes No
If yes, show depth set _____ Feet
If Alternate II completion, cement circulated from _____
feet depth to _____ w/ _____ sx cmt.

RECEIVED
SEP 10 1991
STATE CORPORATION COMMISSION
OIL & GAS CONSERVATION DIVISION
Wichita, Kansas

INSTRUCTIONS: This form shall be completed in triplicate and filed with the Kansas Corporation Commission, 200 Colorado Derby Building, Wichita, Kansas 67202, within 120 days of the spud date of any well. Rule 82-3-130, 82-3-107 and 82-3-106 apply. Information on side two of this form will be held confidential for a period of 12 months if requested in writing and submitted with the form. See rule 82-3-107 for confidentiality in excess of 12 months. One copy of all wireline logs and drillers time log shall be attached with this form. ALL CEMENTING TICKETS MUST BE ATTACHED. Submit CP-4 form with all plugged wells. Submit CP-111 form with all temporarily abandoned wells. Any recompletion, workover or conversion of a well requires filing of ACO-2 within 120 days from commencement date of such work.

All requirements of the statutes, rules and regulations promulgated to regulate the oil and gas industry have been fully complied with and the statements herein are complete and correct to the best of my knowledge.

Signature [Signature]
Title President Date 8-30-91
Subscribed and sworn to before me this 30 day of August, 1991.
Notary Public Deborah Ann Paulus

K.C.C. OFFICE USE ONLY
F Letter of Confidentiality Attached
C Wireline Log Received
C Drillers Timelog Received
Distribution
 KCC SWD/Rep NGPA
 KGS Plug Other (Specify)

Date Commission Expires 1-8-92
DEBORAH ANN PAULUS
NOTARY PUBLIC
STATE OF KANSAS
My Appt. Exp. 1-8-92

P1



Natural Gas • Crude Oil
Exploration & Production

McCOY PETROLEUM CORPORATION

110 South Main, Suite 500
Wichita, Kansas 67202

316-265-9697

ORIGINAL
KCC

SEP 0 6

CONFIDENTIAL

John Roger McCoy
President

Kevin McCoy
Vice-President

Harvey H. McCoy
Vice-President

Keith McCoy
Treasurer

RELEASED

OCT 0 7 1992

FROM CONFIDENTIAL

Brookover "A" #1-7
C NW SE Section 7-25S-32W
Finney County, Kansas

Page 2 (ACO-1)

DST #1 4546-4570' (Pawnee)

Open 30", S.I. 60", Open 60", S.I. 90"

Strong blow, BB/5" on 1st open. 1" BB.

Strong blow, BB/10" on 2nd open.

Recovered 215' of gas in pipe,

30' of clean oil,

90' of oil and mud cut water (10% oil),

1,210' of slightly oil cut water (3% oil).

FP 70-280# 345-610#

ISIP 1280# FSIP 1280#

RECEIVED
STATE COMMISSION

SEP 10 1991

CONCESSION DIVISION
Wichita, Kansas

ELECTRIC LOG TOPS

Heebner	3903	(- 992)
Lansing	3950	(-1039)
Marmaton	4468	(-1557)
Pawnee	4552	(-1641)
Cherokee	4593	(-1682)
Morrow Shale	4791	(-1880)
St. Genevieve	4802	(-1891)
St. Louis	4854	(-1940)
RTD	5150	(-2239)