

STATE CORPORATION COMMISSION OF KANSAS
OIL & GAS CONSERVATION DIVISION

WELL COMPLETION OR RECOMPLETION FORM
ACO-1 WELL HISTORY

DESCRIPTION OF WELL AND LEASE

Operator: License # 5015
Name Hellar Drilling Co., Inc.
Address 125 N. Market, Suite 1422
City/State/Zip Wichita, Kansas 67202

Operator Contact Person D. L. Hellar
Phone (316) 267-2845

Contractor: License # 5104
Name Blue Goose Drilling, Inc.

Wellsite Geologist Donald R. Douglass
Phone (316) 722-4873

PURCHASER

Designate Type of Completion
 New Well Re-Entry Workover
 Oil SWD Temp Abd
 Gas Inj Delayed Comp.
 Dry Other (Core, Water Supply etc.)

If OWWO: old well info as follows:
Operator
Well Name
Comp. Date Old Total Depth

WELL HISTORY

Drilling Method:
 Mud Rotary Air Rotary Cable

11/10/89 11/21/89 11/21/89
Spud Date Date Reached TD Completion Date

4810'
Total Depth PBTD

Amount of Surface Pipe Set and Cemented at 378 feet

Multiple Stage Cementing Collar Used? Yes No
If yes, show depth set feet

If alternate 2 completion, cement circulated
from feet depth to w/SX cmt
A+I OYA

API NO. 15-057,20,477-0000

County Ford

C. N/2 N/2 NE/4 Sec. 35 Twp. 25 Rge. 21 East West

4950 Ft North from Southeast Corner of Section
1320 Ft West from Southeast Corner of Section
(Note: Locate well in section plat below)


Lease Name Kate Well # 4

Field Name Coon Creek North

Producing Formation

Elevation: Ground 2289 KB 2299

Section Plat

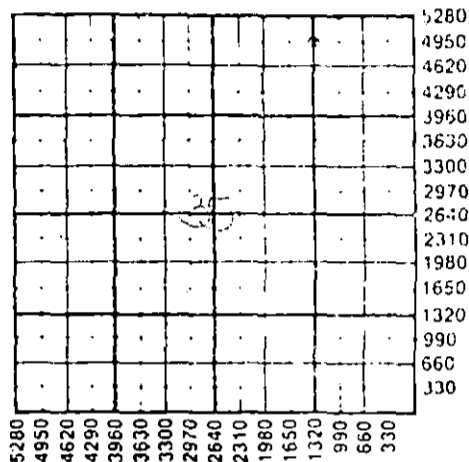

WATER SUPPLY INFORMATION

Source of Water:
Division of Water Resources Permit #

Groundwater Ft North from Southeast Corner
(Well) Ft West from Southeast Corner of
Sec Twp Rge East West

Surface Water Ft North from Southeast Corner
(Stream, pond etc) Ft West from Southeast Corner
Sec Twp Rge East West

Other (explain) hauled from irrigation well
(purchased from city, R.W.D.#)

Disposition of Produced Water: Disposal Repressuring

Docket #

INSTRUCTIONS: This form shall be completed in duplicate and filed with the Kansas Corporation Commission, 200 Colorado Derby Building, Wichita, Kansas 67202, within 90 days after completion or recompletion of any well. Rule 82-3-130 and 82-3-107 apply. Information on side two of this form will be held confidential for a period of 12 months if requested in writing and submitted with the form. See rule 82-3-107 for confidentiality in excess of 12 months. One copy of all wireline logs and drillers time log shall be attached with this form. Submit CP-4 form with all plugged wells. Submit CP-111 form with all temporarily abandoned wells.

All requirements of the statutes, rules and regulations promulgated to regulate the oil and gas industry have been fully complied with and the statements herein are complete and correct to the best of my knowledge.

Signature

Title President Date 12/13/89

Subscribed and sworn to before me this 13th day of December 1989

Notary Public Date Commission Expires

K.C.C. OFFICE USE ONLY
 Letter of Confidentiality Attached
 Wireline Log Received
 Drillers Time Log Received
Distribution
 KCC SWD/Rep NGPA
 KGS Plug Other (Specify)

SEDC. ON CO...
MY APPT. EXP. 3/2/92

X