

15.047.10057-0000

WELL PLUGGING RECORD

NORTH		Location as "NE/CNW%SW%" or footage from lines
		Lease Owner <u>Clark Knight Drilling Co., Inc.</u>
		Lease Name <u>Giles</u> Well No. <u>4</u>
		Office Address
		Character of Well (completed as Oil, Gas or Dry Hole) <u>Dry Hole</u>
		Date well completed <u>10-3</u> 19 <u>58</u>
		Application for plugging filed <u>19</u>
		Application for plugging approved <u>19</u>
		Plugging commenced <u>10-3-58</u> <u>19</u>
		Plugging completed <u>10-3-58</u> <u>19</u>
		Reason for abandonment of well or producing formation <u>Dry</u>
		If a producing well is abandoned, date of last production <u>19</u>

Locate well correctly on above
Section Plat Was permission obtained from the Conservation Division or its agents before plugging was commenced? Yes

Name of Conservation Agent who supervised plugging of this well _____
Producing formation _____ Depth to top _____ Bottom _____ Total Depth of Well 4545 Feet
Show depth and thickness of all water, oil and gas formations.

OIL, GAS OR WATER RECORDS

CASING RECORD

Describe in detail the manner in which the well was plugged, indicating where the mud fluid was placed and the method or methods used in introducing it into the hole. If cement or other plugs were used, state the character of same and depth placed, from _____ feet to _____ feet for each plug set.

Circulated heavy mud to bottom

Filled hole with mud to 350 ft.

Set wood plug - 1/3 sx. C. S. Hulls and 20 sx Cement thru D. P. @ 350'

Finished filling hole to 40' - below Bottom of cellar

Set wood plug and 1/3 sx Hulls and 10 sx cement

Name of Plugging Contractor Ari-Kan Drilling Company (If additional description is necessary, use BACK of this sheet)
Address Great Bend Kansas


STATE OF Kansas COUNTY OF Barton, ss.
Floyd Smith (employee of owner) or (owner or operator) of the above-described
well, being first duly sworn on oath, says: That I have knowledge of the facts, statements, and matters herein contained and the log of the
above-described well as filed and that the same are true and correct. So help me God.

(Signature) Lloyd W. Smith
P.O. Box 162 - Great Bend, Kansas

SUBSCRIBED AND SWEARN TO before me this 15th day of November 1913 58
(Address)

My commission expires April 1, 1959

Notary Public.

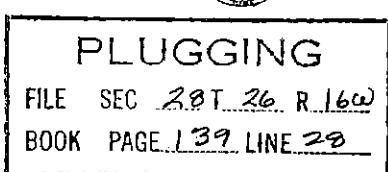

15-047-10057-0000

Company: Clark Knight Drilling Co., Inc.
 Farm: Giles No. 4

Sec. 28-26S-16W
 SW NW NE

Total Depth: 4,545 T. D.

County - Edwards

Comm: 9-16-58 Comp: 10-4-58

Elevation: 2085' RB

Contractor: Clark Knight d/b/a Ari-Kan Drilling Company

Casing: 8 5/8" Cemented at 361' with 225 sacks.

Figures indicate Bottom of Formation

Sand and Clay	30
Sand and Gravel	260
Shale	310
Sand	345
Shale	361
Sand and shale	490
Red Bed	590
Red Bed and shale	695
Sand and Shale	745
Sand	875
Shale	940
Red Bed	1090
Anhydrite	1107
Shale and shells	1340
Shale and shell	1550
Salt, Shale and shell	1730
Shale and shells	2015
Lime and Shale	2315
Lime	2460
Lime and shale	2530
Lime	2600
Shale and Shell	2680
Shale and Lime	2750
Lime and Shale	2820
Shale and shell	2935
Shale and Lime	3070
Shale and Lime	3255
Shale and shells	3315
Lime and shale	3405
Lime and shale	3495
Shale and Lime	3600
Lime	3627
Lime and shale	3810
Lime	3820
Heb. Shale	3826
Lime and Shale	3971
Lime	4395
Lime and shale	4460
Core #1	4475
Shale, Lime and Chert	4511
Core #2	4518
Shale and Sand	4528
Lime and Chert.	4545

T. D. 4545'

RECEIVED
 STATE CORPORATION COMMISSION
 FEB 19 1959
 CONSERVATION DIVISION

RECEIVED
 STATE CORPORATION COMMISSION
 FEB 19 1959
 CONSERVATION DIVISION

PLUGGING
FILE SEC. 28 T. 26 R. 16W
BOOK PAGE 139 LINE 28