


WELL PLUGGING RECORD

Give All Information Completely
Make Required Affidavit
Mail or Deliver Report to:
Conservation Division
State Corporation Commission
211 No. Broadway
Wichita, Kansas

NORTH

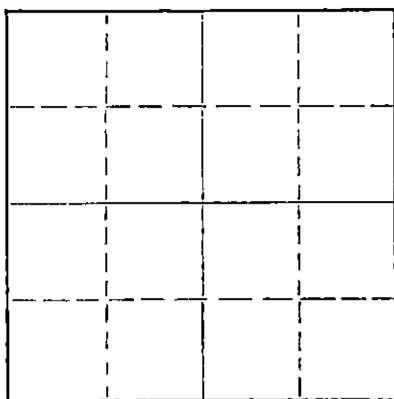

Locate well correctly on above
Section Plat

Edwards County. Sec. 33 Twp. 26S Rge. (E) 16 (W)
Location as "NE/CNW&SW4" or footage from lines NE NE SW
Lease Owner Sunray Mid-Continent Oil Company
Lease Name King Well No. 1
Office Address Box # 788, Great Bend, Kansas
Character of Well (completed as Oil, Gas or Dry Hole) Gas
Date well completed Nov. 18, 19 56
Application for plugging filed Jan. 19, 19 59
Application for plugging approved Jan. 20, 19 59
Plugging commenced Feb. 5, 19 59
Plugging completed Feb. 10, 19 59
Reason for abandonment of well or producing formation Failed to be a commercial
Producer.
If a producing well is abandoned, date of last production Jan. 8, 19 58
Was permission obtained from the Conservation Division or its agents before plugging was commenced? Yes

Name of Conservation Agent who supervised plugging of this well Frank Broadfoot
Producing formation _____ Depth to top _____ Bottom _____ Total Depth of Well 4876 Feet
Show depth and thickness of all water, oil and gas formations.

OIL, GAS OR WATER RECORDS

CASING RECORD

FORMATION	CONTENT	FROM	TO	SIZE	PUT IN	PULLED OUT
				8 5/8"	402'	None
				5 1/2"	4637'	3512'

Describe in detail the manner in which the well was plugged, indicating where the mud fluid was placed and the method or methods used in introducing it into the hole. If cement or other plugs were used, state the character of same and depth placed, from _____ feet to _____ feet for each plug set.

Checked the hole to 4568' and found it open.
Filled w/sand to 4522' and dumped 5 sacks of
cement with bailer. Filled 5 1/2" casing,
cleared hole and bailed off oil and fluid to
good mud at 250', set rock bridge to 240' and
ran 20 sacks of cement. Mudded the hole to
40', set rock bridge to 30' and ran 10 sacks
of cement to base of cellar.

Plugging completed

RECEIVED
STATE CORPORATION COMMISSION

FEB 20 1959

Log attached.

CONSERVATION DIVISION
Wichita, Kansas

(If additional description is necessary, use BACK of this sheet)

Name of Plugging Contractor West Supply Company
Address Chase, Kansas

STATE OF KANSAS COUNTY OF BARTON, ss.
N. E. Montgomery (employee of owner) or (~~owner or operator~~) of the above-described
well, being first duly sworn on oath, says: That I have knowledge of the facts, statements, and matters herein contained and the log of the
above-described well as filed and that the same are true and correct. So help me God.

(Signature) N. E. Montgomery
Box # 788, Great Bend, Kansas
(Address)

SUBSCRIBED AND SWORN TO before me this 19th day of February, 19 59

My commission expires Dec. 24, 1960

Notary Public.

PLUGGING
FILE SEC 33 T. 26 R. 16 W
BOOK PAGE 11 LINE 7

15-047-00037-0000

Sunray Mid-Continent Oil Company
Tulsa, Oklahoma

Tulsa, Oklahoma
November 12, 1956

CONTRACTOR: Stickle Drilling Company
Drilling Commenced: October 20, 1956
Drilling Completed: November 8, 1956

H. King #1 - SW/4 of
Section 33-26S-16W -
Edwards County, Kansas.

DRILLERS LOG

Depth Figures Indicate Base of Formation

Sand	250
Red Bed	402
Red Bed & Shale	465
Anhydrite	500
Red Bed, Shale & Shells	1025
Red Bed & Shale	1080
Anhydrite	1110
Shale & Shells	1930
Lime & Shale	2070
Lime	2195
Lime & Shale Streaks	2335
Lime & Shale	3990
Lime	4330
Lime & Shale	4400
Shale & Lime	4455
Shale & Conglomerate	4492
Lime & Chert	4527
Chert Shale & Sand	4551
Lime Chert	4567
Sand, Chert, & Lime	4619
Chert & Lime	4714
Chert, Lime & Shale	4774
Shale & Sand	4850
Lime & Chert	4876 TD

I, Lillian T. Bonham, hereby certify the above to be a true and complete Driller's Log of Sunray Mid-Continent Oil Company's H. King #1 - SW/4 of Section 33-26S-16W, Edwards County, Kansas.

Lillian T. Bonham
Lillian T. Bonham, Asst. Secy.

Edward Eckel
Notary Public

June 26, 1957
My Commission Expires

PLUGGING
FILE SEC 33 T 26 R 16 W
BOOK PAGE 11 LINE 7