

STATE OF KANSAS
STATE CORPORATION COMMISSION


WELL PLUGGING RECORD

Give All Information Completely
Make Required Affidavit
Mail or Deliver Report to:
Conservation Division
State Corporation Commission
800 Bitting Building
Wichita, Kansas

Reno County. Sec. 26 Twp. 24 Rge. 8 (E) (W)

Location as "NE/CNW $\frac{1}{4}$ SW $\frac{1}{4}$ " or footage from lines SW SW SW
Lease Owner J. A. Melland
Lease Name Linscheid Well No. 1
Office Address 1111 No. Main, Hutchinson, Kans.
Character of Well (completed as Oil, Gas or Dry Hole) Dry Hole
Date well completed Aug. 22, 19 50
Application for plugging filed Aug. 23, 19 50
Application for plugging approved (Verbally) Aug. 23, 19 50
Plugging commenced Aug. 23, 19 50
Plugging completed Aug. 23, 19 50
Reason for abandonment of well or producing formation Dry Hole

NORTH

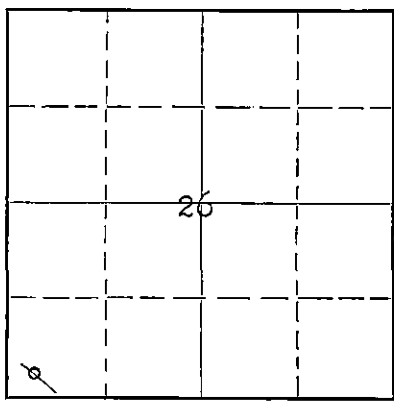

Locate well correctly on above Section Plat

If a producing well is abandoned, date of last production 19...
Was permission obtained from the Conservation Division or its agents before plugging was commenced? Yes

Name of Conservation Agent who supervised plugging of this well C. D. Stough
Producing formation Depth to top Bottom Total Depth of Well 4245 Feet
Show depth and thickness of all water, oil and gas formations.

OIL, GAS OR WATER RECORDS

CASING RECORD

Formation	Content	From	To	Size	Put In	Pulled Out
Mississippi Lime	Dry	3758	3855	10-3/4"OD	160'	0
Simpson Shale	Dry	4126	4138			
Simpson Sand	Dry	4138	4161			
Arbuckle Lime	Dry	4212	4245			

Describe in detail the manner in which the well was plugged, indicating where the mud fluid was placed and the method or methods used in introducing it into the hole. If cement or other plugs were used, state the character of same and depth placed, from feet to feet for each plug set.

Heavy Rotary Mud 4245 to 150
20 Sacks of Cement set at 150
Heavy Rotary Mud 130 to 25
10 sacks of Cement set at 25
Heavy mud to bottom of cellar
Cellar filled with surface soil to top of ground

RECEIVED
Conservation Div.
AUG 26 1950
STATE CORPORATION COMMISSION
8-26-50


(If additional description is necessary, use BACK of this sheet)
Correspondence regarding this well should be addressed to J. A. Melland
Address 1111 No. Main, Hutchinson, Kansas

STATE OF Kansas, COUNTY OF Reno, ss.
J. A. Melland (employee of owner) or (owner or operator) of the above-described well,
being first duly sworn on oath, says: That I have knowledge of the facts, statements, and matters herein contained and the log of the above-described well as filed and that the same are true and correct. So help me God.
(Signature) J. A. Melland
1111 No. Main, Hutchinson, Kansas (Address)

SUBSCRIBED AND SWORN TO before me this 24th day of August, 1950.

Josephine L. Johnson Notary Public.

My commission expires April 7, 1951

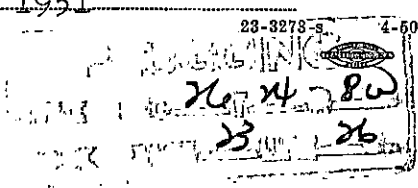

OWNER J. A. Melland

LEASE Linscheid

WELL NO. 1

LOCATION SW SW SW, Sec. 26-24S-8W, Reno County, Kansas

CONTRACTOR: J. A. Melland, 1111 No. Main, Hutchinson, Kansas

COMMENCED DRILLING August 4, 1950

FINISHED DRILLING August 22, 1950

HOLE PLUGGED August 23, 1950

15-155-00433-0000

Ground Elevation 1627'

Consulting Geologists: Lerke & Whorton, Wichita, Kansas

FORMATION	FROM	TO	REMARKS
Surface Clay	0	40	
Shale and Sand	40	100	
Red Shale & Shells	100	160	Set & cemented 160' of 10-3/4" OD Steel Csg. at 160' w/ 75 sacks of cement. Finished at 11:30 PM 8/4/50 Recemented 10-3/4" csg. w/ 50 sacks of cement - Finished at 11:15 PM, 8/6/50.
Sand & shells	160	240	
Shale and shells	240	300	
Shale	300	700	
Shells and shale	700	1140	
Lime and shale	1140	1195	
Sand and shale	1195	1320	
Shale and lime	1320	1362	
Anhydrite	1362	1380	
Lime and shale	1380	1900	
Lime	1900	1925	
Lime and shale	1925	1990	
Lime	1990	2030	
Shale	2030	2255	
Lime and shale	2255	2565	
Shale	2565	2670	
Lime	2670	2727	
Shale	2727	2739	
Lime	2739	2795	
Lime and shale	2795	2815	
Lime	2815	2865	
Shale and lime	2865	2960	
Lime	2960	2995	
Black Shale	2995	3005	
Lime and grey shale	3005	3023	
Lime	3023	3062	
Lime and shale	3062	3111	
Sand	3111	3200	
Shale	3200	3220	
Shale and lime	3220	3275	
Lime	3275	3335	
Lime	3335	3555	
Lime and shale	3555	3667	
Shale	3667	3755	
Lime	3755	3766	Top Mississippi Lime at 3758' Circulated at 3766', some stain & saturation in weathered chert. Trace of oil stain at 3769' Trace of oil stain at 3784' Soft weathered chert at 3809', no shows.
Lime & chert	3766	3791	Base Mississippi Lime at 3855'
Lime	3791	3855	
Shale	3855	3945	
Shale	3945	4070	
White chert	4070	4075	
Shale	4075	4110	
White chert	4110	4115	
Shale	4115	4125	
Shale and sand	4125	4126	
Shale and sand	4126	4138	Top Simpson Shale at 4126' Top Simpson Sand at 4138' Trace of free oil Drill Stem Test at 4138'-4144', open 30 minutes, recovered 15' of water cut mud. No odor in any of the above shows

STATE OF KANSAS
COMMISSIONER OF GEOL. & MINES
AUG 26 1950

8-2650

PLUGGING
FILE SEC 26 T 24 R 8 W
BLOCK PAGE 23 LINE 26

FORMATION	FROM	TO	REMARKS
Sand	4138	4161	
Shale	4161	4180	
Shale and sand	4180	4212	Top Arbuckle Line at 4212'
Lime	4212	4245	No shows
Rotary Total Depth		4245'	

As no oil or gas in commercial quantities was encountered during the drilling of this well, the hole was plugged as per instructions of Mr. C. D. Stough, S.C.C. Well Plugging Supervisor.

Heavy mud 4245 150
 20 sacks of cement at 150
 Heavy mud 130 25
 10 sacks of cement at 25
 Heavy mud to bottom of cellar
 Cellar filled with surface soil to top of ground
 Plugging completed August 23, 1950.

RECEIVED
 AUG 26 1950
 STATE CORPORATION
 COMMISSION
 KANSAS
 8-26-50