


STATE OF KANSAS  
STATE CORPORATION COMMISSION

WELL PLUGGING RECORD

Give All Information Completely  
Make Required Affidavit  
Mail or Deliver Report to:  
Conservation Division  
State Corporation Commission  
212 North Market, Insurance Bldg.  
Wichita, Kansas

NORTH

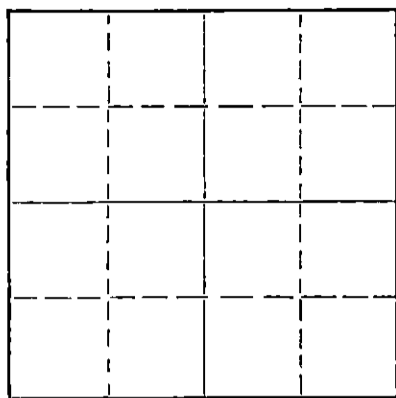

Locate well correctly on above  
Section Plat

Reno County. Sec. 25 Twp. 24S Rge. 8 (E) W (W)  
Location as "NE/CNW/SW" or footage from lines 900' E/WL, 330' S/NL of SW/4  
Lease Owner: Mohawk Drilling & Development Co.  
Lease Name: Wedelin Well No. 1  
Office Address: Box 624 - Hutchinson, Kansas  
Character of Well (completed as Oil, Gas or Dry Hole) Dry Hole  
Date well completed March 15 19 60  
Application for plugging filed March 15 19 60  
Application for plugging approved March 15 19 60  
Plugging commenced March 15 19 60  
Plugging completed March 15 19 60  
Reason for abandonment of well or producing formation Dry Hole

If a producing well is abandoned, date of last production 19  
Was permission obtained from the Conservation Division or its agents before plugging was commenced? yes

Name of Conservation Agent who supervised plugging of this well Fred Hampel - Pretty Prairie, Kansas  
Producing formation Depth to top Bottom Total Depth of Well 3887 Feet  
Show depth and thickness of all water, oil and gas formations.

OIL, GAS OR WATER RECORDS

CASING RECORD

FORMATION	CONTENT	FROM	TO	SIZE	PUT IN	PULLED OUT
		0	219'	8 5/8"	219'	None

Describe in detail the manner in which the well was plugged, indicating where the mud fluid was placed and the method or methods used in introducing it into the hole. If cement or other plugs were used, state the character of same and depth placed, from feet to feet for each plug set.

From 3887' to 210' - heavy rotary mud  
210' to 164' - plug, 1/4 sk. hulls & 15 sks. cement  
164' to 40' - heavy rotary mud  
40' to 6' - plug, 1/4 sk. hulls & 10 sks. cement  
6' to surface - cellar

RECEIVED  
STATE CORPORATION COMMISSION

APR 12 1960

CONSERVATION DIVISION  
Wichita, Kansas

4-6-60

(If additional description is necessary, use BACK of this sheet)  
Name of Plugging Contractor Peel Brothers, Inc.  
Address P.O. Box 359 - Hoisington, Kansas

STATE OF KANSAS, COUNTY OF BARTON, ss.  
Peel Brothers, Inc. (employee of owner) or (owner or operator) of the above-described well, being first duly sworn on oath, says: That I have knowledge of the facts, statements, and matters herein contained and the log of the above-described well as filed and that the same are true and correct. So help me God. PEEL BROTHERS, INC.

(Signature) BY: Wendell K. Peel  
P.O. Box 359 - Hoisington, Kansas  
(Address)

SUBSCRIBED AND SWORN TO before me this 17th day of March, 19 60  
Lush Brant  
Notary Public.

My commission expires April 27, 1960



DRILLERS' LOG

Well Owner: Mohawk Drilling & Development Co.  
 Farm Name: Wedelin Well No. 1  
 Total Depth: 3887'  
 Commenced: 3/4/60  
 Completed: 3/15/60  
 Casing: 8 5/8" @ 219' cemented  
 Contractor: Peel Brothers, Inc.

900' E/WL, 330' S/NL,  
 of SW/4  
 Sec. 25-24S-8W  
 Reno County, Kansas  
 Elevation: 1644 RB  
 Production: Dry

Figures below indicate bottoms of formations:

Clay	0	15
Sand		110
Shale		220
Shale & red bed		450
Shale & shells		1060
Anhydrite		1075
Shale & shells		1130
Lime		1455
Lime & shale		1680
Lime		1800
Lime & shale		2690
Lime		3035
Broken lime		3120
Sand		3186
Shale & lime		3205
Lime		3704
Lime & shale		3780
Miss. chat		3810
Miss. chert		3887
Total Depth		3887

This is to certify that the above information is to the best of our knowledge, true and correct.

PEEL BROTHERS, INC.

*Mendell K. Peel*  
 BY \_\_\_\_\_

SUBSCRIBED AND SWORN to before me this 17th day of March, 1960

My commission expires: April 27, 1960

*Luth Brank*  
 \_\_\_\_\_  
 Notary Public

RECEIVED  
 STATE CORPORATION COMMISSION

APR 12 1960

CONSERVATION DIVISION  
 Wichita, Kansas

4-6-60