

15-155-00051-0000

WELL PLUGGING RECORD

STATE OF KANSAS STATE CORPORATION COMMISSION

FORMATION PLUGGING RECORD

Give All Information Completely Make Required Affidavit Mail or Deliver Report to: Conservation Division State Corporation Commission 800 Bitting Building Wichita, Kansas

Strike out upper line when reporting plugging of formations.

Reno County, Sec. 3 Twp. 24S Rge. 8W (E) (W)

Location as "NE 1/4 NW 1/4 SW 1/4" or footage from lines. NE 1/4 NE 1/4 SE 1/4

Lease Owner Ector Oil Company

Lease Name Rothenberg Well No. 1

Office Address Philtower, Tulsa, Oklahoma

Character of Well (completed as Oil, Gas or Dry Hole) Dry Hole

Date well completed January 1 19 51

Application for plugging filed January 2 19 51

Application for plugging approved January 2 19 51


Plugging commenced January 2 19 51

Plugging completed January 2 19 51

Reason for abandonment of well or producing formation Dry Hole

If a producing well is abandoned, date of last production 19

Was permission obtained from the Conservation Division or its agents before plugging was commenced? Yes

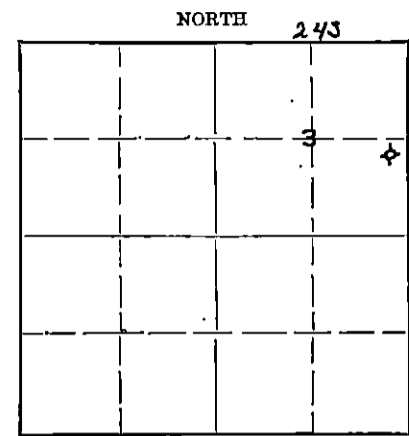

Locate well correctly on above Section Plat

Name of Conservation Agent who supervised plugging of this well Mr. Durkee - McPherson, Kansas

Producing formation Depth to top Bottom Total Depth of Well 4200 Feet

Show depth and thickness of all water, oil and gas formations.

OIL, GAS OR WATER RECORDS

CASING RECORD

Table with 7 columns: Formation, Content, From, To, Size, Put In, Pulled Out. Row 1: Surface Casing, 8-5/8, 205.

Describe in detail the manner in which the well was plugged, indicating where the mud fluid was placed and the method or methods used in introducing it into the hole. If cement or other plugs were used, state the character of same and depth placed, from feet to feet for each plug set.

Filled up bottom of hole with mud. Cemented at 200 feet with 15 sacks of cement, then filled surface pipe with mud. 5 sacks of cement on top of hole.

RECEIVED CONSERVATION COMMISSION JAN 20 1951 1-20-51 CONSERVATION DIVISION WICHITA, KANSAS

(If additional description is necessary, use BACK of this sheet)

Correspondence regarding this well should be addressed to Ector Oil Company, Philtower Building, Tulsa, Oklahoma

STATE OF Oklahoma COUNTY OF Tulsa, ss.

Fred McConnell (employee of owner) or (owner or operator) of the above-described well, being first duly sworn on oath, says: That I have knowledge of the facts, statements, and matters herein contained and the log of the above-described well as filed and that the same are true and correct. So help me God.

(Signature) Fred McConnell President ECTOR OIL COMPANY

510 Philtower Bldg., Tulsa, Okla. (Address)

SUBSCRIBED AND SWORN to before me this 19th day of January, 19 51

Notary Public signature and name

My commission expires May 4, 1954

PLUGGING FILE SEC 3 T 24 R 2 W BOOK PAGE 53 LINE 34

15-155-00051-0000

NOTHING I

SE 1/4 Section 3-24E-50,  
Beno County, Kansas  
Ector Oil Company

Drilling Commenced 12-16-50  
Drilling Completed 12-31-50

8-5/8" C. D. Casing Cemented at 205'

FROM	TO	DESCRIPTION	REMARKS
0'	95'	Shale & sand	
95	520	Red bed	8-5/8" C. D. casing cemented
520	865	Shale & shells	with 225 sacks cement at 205'
865	1255	Shale & salt	
1255	1475	Shale & lime	
1475	1605	Lime	
1605	1775	Shale & lime	
1775	1925	Lime & shale	
1925	2415	Shale & shells	
2415	2730	Shale & lime	
2730	2935	Lime	
2935	3115	Lime & shale	
3115	3305	Lime	
3305	3340	Lime & chert	
3340	3565	Lime	
3565	3620	Lime & shale	
3620	3644	Lime	
3644	3697	Lime & shale	
3697	3725	Lime	
3725	3794	Lime & chert	
3794	3838	Lime	
3838	3908	Lime & shale	
3908	3940	Shale	
3940	4000	Lime	
4000	4067	Shale	
4067	4085	Lime	
4085	4115	Lime & shale	
4115	4151	Shale & lime	
4151	4155	Shale	
4155	4200	Lime	Dry hole - well plugged

This is a true copy of the drillers' log as shown on our drilling tickets.

BARBARA MULLER THE COMMISSIONER

*A. M. Bourbon Jr*

Subscribed and sworn to before me this 15th day of January 1951.

*Merry Jane BUSTEVED*  
Notary Public

STATE CORPORATION COMMISSION

My commission expires July 27, 1955.

JAN 20 1951 1-20-51

CONSERVATION DIVISION  
Wichita, Kansas

**PLUGGING**  
 FILE SEC 3 T 24 180  
 BOOK PAGE 53 LINE 34