


STATE OF KANSAS  
STATE CORPORATION COMMISSION

## WELL PLUGGING RECORD

Give All Information Completely  
Make Required Affidavit  
Mail or Deliver Report to  
Conservation Division  
State Corporation Comm.  
245 North Water  
Wichita, KS 67202

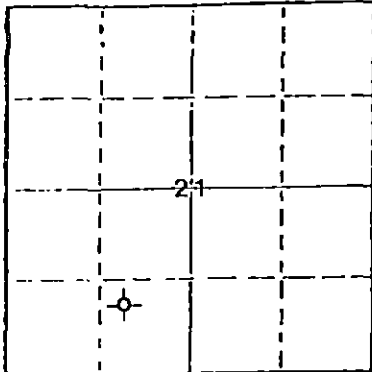

Locate well correctly on above  
Section Plat

Reno County. Sec. 21 Twp. 24S Rge. 7 W E/W  
Location as "NE/CNW $\frac{1}{4}$ SW $\frac{1}{4}$ " or footage from lines 65' E of  
C/NW $\frac{1}{4}$  SE $\frac{1}{4}$  SW $\frac{1}{4}$

Lease Owner Gear Petroleum Co.

Lease Name Miller Well No. 1

Office Address 1325 Vickers-KSB&T Bldg., Wichita, Ks. 67202

Character of Well (Completed as Oil, Gas or Dry Hole)

Dry Hole

Date Well completed 7/12/76 19

Application for plugging filed 7/11/76 19

Application for plugging approved 7/11/76 19

Plugging commenced 7/11/76 19

Plugging completed 7/12/76 19

Reason for abandonment of well or producing formation  
D&A

If a producing well is abandoned, date of last production  
19

Was permission obtained from the Conservation Division or  
its agents before plugging was commenced? yes

Name of Conservation Agent who supervised plugging of this well Gilbert Loman

Producing formation Depth to top Bottom Total Depth of Well 3523'

Show depth and thickness of all water, oil and gas formations.

## OIL, GAS OR WATER RECORDS

## CASING RECORD

FORMATION	CONTENT	FROM	TO	SIZE	PUT IN	PULLED OUT
				8 5/8"	205.97'	-0-

Describe in detail the manner in which the well was plugged, indicating where the mud fluid was placed and the method or methods used in introducing it into the hold. If cement or other plugs were used, state the character of same and depth placed, from \_\_\_\_\_ feet to \_\_\_\_\_ feet for each plug set.

Plug @ 500' w/40 sx cmt

Plug @ 200' w/25 sx cmt

2 sx cmt in rathole

RECEIVED  
STATE CORPORATION COMMISSION

JUL 22 1976

7-22-76

CONSERVATION DIVISION  
WICHITA, KANSAS

(If additional description is necessary, use BACK of this sheet)

Name of Plugging Contractor Allied Cementing & Red Tiger Drilling Co.

STATE OF Kansas COUNTY OF Sedgwick, ss.  
Jean Stocks (employee of owner) or (owner or operator)  
of the above-described well, being first duly sworn on oath, says: That I have knowledge of the facts, statements, and matters herein contained and the log of the above-described well as filed and that the same are true and correct. So help me God.

(Signature)

1720 KSB&T Bldg., Wichita, Ks. 67202

(Address)

SUBSCRIBED AND SWORN TO before me this 16th day of July, 1976

My commission expires



Notary Public.

Copy to St. Corp. Comm.  
7-21-76

Drillers Log

No. 1 Miller

CASING RECORD: 8 5/8" @ 213' w/165 sx cmt  
 COMPANY: Gear Petroleum Company  
 CONTRACTOR: Red Tiger Drilling Company  
 COMMENCED: July 7, 1976  
 COMPLETED: July 12, 1976  
 DESCRIPTION: 65' E of C/NW $\frac{1}{4}$  SE $\frac{1}{4}$  SW $\frac{1}{4}$  Sec. 21-T24S-R7W Rooks County, Kansas  
 TOTAL DEPTH: 3523' ELEVATION: 1606' GL

<u>FORMATION</u>	<u>FROM</u>	<u>TO</u>	<u>REMARKS</u>
Sand	0	40	
Sand	40	217	
Redbeds & Gray Shale	217	330	
Shale	330	1110	
Lime	1110	1160	
Lime	1160	1269	
Lime & Shale	1269	1382	
Lime	1382	1610	
Lime	1610	1900	
Lime	1900	2165	
Lime	2165	2405	
Lime & Shale	2405	2462	
Lime	2462	2545	
Lime	2545	2797	
Lime & Sand	2797	2995	
Lime & Shale	2995	3185	
Lime	3185	3307	
Lime	3307	3385	
Lime	3385	3485	
Lime	3485	3523	
RTD		3523	

STC  
 JUL 21 1976  
 7-22-76  
 Check with record  
 V. L. L. L. L.

I certify that this is a true and correct copy of the above log to the best of my knowledge.

RED TIGER DRILLING COMPANY

Jean Stocks  
 Jean Stocks

Subscribed & sworn to  
 before me this 16th day of July, 1976.

D'Ann Drennan  
 Notary Public

