


STATE OF KANSAS
STATE CORPORATION COMMISSION

Form CP-4

Give All Information Completely
Make Required Affidavit
Mail or Deliver Report to:
Conservation Division
State Corporation Commission
P. O. Box 17027
Wichita, Kansas 67217
NORTH

WELL PLUGGING RECORD

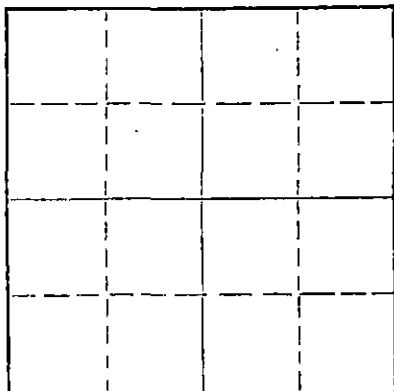

Locate well correctly on above
Section Plat

Edwards County. Sec. 36 Twp. 25 Rge. 16 (E) (W) X
Location as "NE/CNW\SW\SE" or footage from lipes SE SE NW
Lease Owner National Cooperative Refining Assoc.
Lease Name Cudney Well No. #1
Office Address Box 6 Great Bend, Kansas
Character of Well (completed as Oil, Gas or Dry Hole)
Date well completed 19
Application for plugging filed 19
Application for plugging approved 19
Plugging commenced 6-4-73 19
Plugging completed 6-7-73 19
Reason for abandonment of well or producing formation

If a producing well is abandoned, date of last production 19
Was permission obtained from the Conservation Division or its agents before plugging was commenced?

Name of Conservation Agent who supervised plugging of this well G. R. Biberstein
Producing formation Depth to top Bottom Total Depth of Well 4497' Feet
Show depth and thickness of all water, oil and gas formations.

OIL, GAS OR WATER RECORDS

CASING RECORD

FORMATION	CONTENT	FROM	TO	SIZE	PUT IN	PULLED OUT
				5 1/2"	4495'	2708.32'
				8 5/8"	407'	

Describe in detail the manner in which the well was plugged, indicating where the mud fluid was placed and the method or methods used in introducing it into the hole. If cement or other plugs were used, state the character of same and depth placed, from feet to feet for each plug set.

Made bottom hole plug back with sand from 4460' to 4300'. Mixed and ran 5 sacks cement thru dump bailer, from 4300' to 4260'.
Squeezed hole with 3 sacks hulls - 20 sacks gel. Released plug and displaced with 100 sacks cement.

RECEIVED
STATE CORPORATION COMMISSION
JUN 11 1973
6-11-73
CONSERVATION DIVISION
Wichita, Kansas

(If additional description is necessary, use BACK of this sheet)
Name of Plugging Contractor Southwest Casing Pulling Co.
Address Box 364 Great Bend, Kansas

STATE OF Kansas, COUNTY OF Barton, ss.
Southwest Casing Pulling Co. (employee of owner) or (owner or operator) of the above-described well, being first duly sworn on oath, says: That I have knowledge of the facts, statements, and matters herein contained and the log of the above-described well as filed and that the same are true and correct. So help me God.

(Signature) W. C. Spencer
Box 364 Great Bend, Kansas
(Address)

Subscribed and sworn to before me this 8 day of June, 19 73

Sidney D. Miller
Notary Public.

My commission expires 24 October 1976



National Coop Refinery Assn - Owner

State Petroleum - Contr.

CHESEBROUGH

SE SE 1/4 Sec. 36-25S-16W
Edward County, Kansas

Flow: 2952 D.F.
Total Depth: 4497'

Comm: 10/11/58
Comp: 10/25/58

Casing:

Cements:

8 5/8 @ R.B. 407'
5 1/2 @ 4497'

with 27' sks
with 50 sks, 260 gal Latex

FORMATION

DEPTH

Sand	0'
Shale	310
Red Bed	320
Shale, shells & pyrite	403
Red bed	1050
Shale, salt & shells	1966
Lime & shale	2360
Lime	2455
Lime & shale	3719
Lime, shale & sand	3814
Lime & shale	3994
Lime	4310
Lime shale & chert	4358
Chert	4394
Chert, shale & sand	4415
Sand & shale	4430
Chert	4490
Viola	4497
Tops:	
Anhydrite	1035
Beebe	3714
Toronto	3733
Brown Lime	3759
Lansing K.C.	3839
Conglomerate	4249
Mississippi	4335
Kinderhook Sand	4409
Viola	4472

RECEIVED
STATE CORPORATION COMMISSION
MAY 10 1973
CONSERVATION DIVISION
Wichita, Kansas

STATE OF KANSAS)
) 551
COUNTY OF RUSSELL)

I hereby certify that the above information is true and correct to the best of my knowledge.

C. P. Honaker

Subscribed and sworn to before me this 27th day of October, 1958.

Margie Cooper
Notary Public

My commission expires: 1-30-61.

[Handwritten signature]