

9


STATE OF KANSAS
STATE CORPORATION COMMISSION

Give All Information Completely
Make Required Affidavit
Mail or Deliver Report to:
Conservation Division
State Corporation Commission
211 No. Broadway
Wichita, Kansas

WELL PLUGGING RECORD

EDWARDS County. Sec. 8 Twp. 25S Rge. (E) 17 (W)
Location as "NE/CNW%SW%" or footage from lines C SE NW
Lease Owner WESTERN PETROLEUM CO., INC.
Lease Name HOFFMAN Well No. 1
Office Address 925 PATTON ROAD, GREAT BEND, KANSAS
Character of Well (completed as Oil, Gas or Dry Hole) DRY HOLE
Date well completed SEPTEMBER 26 19 63
Application for plugging filed SEPTEMBER 26 19 63
Application for plugging approved SEPTEMBER 26 19 63
Plugging commenced 5:00 P.M. SEPTEMBER 26 19 63
Plugging completed 8:00 P.M. SEPTEMBER 26 19 63
Reason for abandonment of well or producing formation DRY HOLE

NORTH

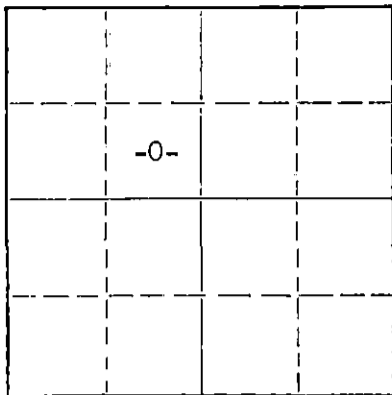

Locate well correctly on above
Section Plat

If a producing well is abandoned, date of last production _____ 19____
Was permission obtained from the Conservation Division or its agents before plugging was commenced? _____

Name of Conservation Agent who supervised plugging of this well ARCHIE V. ELVING
Producing formation _____ Depth to top _____ Bottom _____ Total Depth of Well 4705 Feet
Show depth and thickness of all water, oil and gas formations.

OIL, GAS OR WATER RECORDS

CASING RECORD

FORMATION	CONTENT	FROM	TO	SIZE	PUT IN	PULLED OUT
		-0-	793	8-5/8"	9/12/63	

Describe in detail the manner in which the well was plugged, indicating where the mud fluid was placed and the method or methods used in introducing it into the hole. If cement or other plugs were used, state the character of same and depth placed, from _____ feet to _____ feet for each plug set.
FILLED HOLE WITH FLUID TO 300'. PUSHED WOODEN PLUG AND 1/4 SACK HULLS TO FLUID.
CEMENTED WITH 25 SACKS CEMENT. FILLED HOLE TO 40' FLUID. PUSHED PLUG AND 1/4
SACKS HULLS TO FLUID. CEMENTED WITH 10 SACKS CEMENT.
JOB COMPLETED @ 8:00 P.M., 9/26/63.

RECEIVED
STATE CORPORATION COMMISSION
OCT 1 1963
10-1-63
CONSERVATION DIVISION
Wichita, Kansas

(If additional description is necessary, use BACK of this sheet)

Name of Plugging Contractor WESTERN PETROLEUM CO., INC.
Address 925 PATTON ROAD, GREAT BEND, KANSAS

STATE OF KANSAS, COUNTY OF BARTON, ss.
F. I. COPELAND (employee of owner) or (~~owner or operator~~) of the above-described well, being first duly sworn on oath, says: That I have knowledge of the facts, statements, and matters herein contained and the log of the above-described well as filed and that the same are true and correct. So help me God.

(Signature) F. I. Copeland
925 PATTON ROAD, GREAT BEND, KANSAS
(Address)

SUBSCRIBED AND SWORN to before me this 26TH day of SEPTEMBER, 1963

My commission expires SEPTEMBER 15, 1965
Roma Link Notary Public.



DRILLERS LOG

Hoffman #1

COMPANY: Western Petroleum Co., Inc. TOTAL DEPTH: 4705'

CONTRACTOR: Western Petroleum Co., Inc. ELEVATION: 2150' DF;
2152' KB

COMMENCED: September 11, 1963

COMPLETED: September 27, 1963

DESCRIPTION: C SE NW, Sec. 8-T25S-R17W
Edwards County, Kansas

CASING RECORD:
19 Joints of 8-5/8" 28# Rge 3
Surface Casing

<u>FORMATION</u>	<u>FROM</u>	<u>TO</u>	<u>REMARKS</u>
Sand	0	40	Spudded at 12:00 noon, 9/11/63.
Sand & Gravel	40	80	Ran 19 joints of 8-5/8" 28# used pipe,
Sand & Shale	80	484	range 3 (789.29' overall), set at 793',
Red Bed	484	1190	cemented with 600 sacks of common cement,
Anhydrite	1190	1215	3% GC, 3% Gel. Cement circulated.
Shale	1215	1640	Plug down at 10:15 A. M. 9/12/63.
Shale & Shells	1640	2015	
Shale, Shells & Salt	2015	2225	Core #1, 4500-27'. 100% recovery,
Lime & Shale	2225	2370	Mississippian chert.
Lime	2370	2475	
Lime & Shale	2475	2600	Core #2, 4527-4553'. 100% recovery.
Shale, Sand & Lime	2600	2760	
Lime & Shale	2760	3997	DST #1 - 4497-4527'. Open 1-1/4 hours.
Lime	3997	4203	Fair blow throughout test. Recovered
Lime & Shale	4203	4467	1040' visible gas, 40' gas cut mud. No
Chert & Shale	4467	4527	apparent water. IBHP 990#; FBHP
Shale & Sand	4527	4553	1160#/30 min.; IFP - FFP 0#; HH 1995#.
Chert & Lime	4553	4554	
Shale, Chert & Sand	4554	4607	DST #2 - 4524-4554'. Open 1 hour.
Chert & Shale	4607	4623	Weak blow for 34 minutes. Recovered
Chert	4623	4705	33' mud, no shows. IBHP 1360#; FBHP
RTD	4705		1275#/30 min.; IFP - FFP 0#; HH
			2030#.

ELECTRIC LOG TOPS

Anhydrite	1191	4961	Schlumberger ran 27" induction, Sonic, Caliper, Gamma-Ray, Integrated Sonic and SRS logs.
Topeka	3526	1374	
Heebner Shale	3843	1691	P&A 9/27/63.
Iatan Lime	3973	1821	
Lansing	3985	1833	
Conglomerate	4476	2324	
Mississippian	4498	2346	
Kinderhook	4529	2377	
Kinderhook Sand	4543 to 4558		
Viola	4640	2488	
RTD	4705	2553	

RECEIVED
STATE CORPORATION COMMISSION

OCT 7 1963

CONSERVATION DIVISION
Wichita, Kansas

STATE OF KANSAS)
COUNTY OF BARTON) SS.

I, the undersigned, being duly sworn on oath, state that the above statement and log are true and a correct record and log of the well drilled at the location above described.

WESTERN PETROLEUM CO., INC.

F. L. Copeland
F. L. Copeland, Drilling Supt.

Subscribed and sworn to before me this 1st day of October, 1963.

My commission expires 1/15/67.

Reva C. Brown
Reva C. Brown, Notary Public