

WELL PLUGGING RECORD

Give All Information Completely
Make Required Affidavit
Mail or Deliver Report to:
Conservation Division
State Corporation Commission
800 Bittig Building
Wichita, Kansas

Edwards

County. Sec. 9 Twp. 25S Rge. 17 (E) W (W)

Location as "NE/CNW/SW" or footage from lines SW/4 SW/4 NW/4

Lease Owner Twin Oil Corporation

Lease Name Britton Well No. 1

Office Address 2706 Republic National Bank Bldg., Dallas, Texas

Character of Well (completed as Oil, Gas or Dry Hole) Dry Hole

Date well completed September 28, 1954

Application for plugging filed (verbal) September 28, 1954

Application for plugging approved (verbal) September 28, 1954


Plugging commenced September 28, 1954

Plugging completed September 28, 1954

Reason for abandonment of well or producing formation Dry Hole

If a producing well is abandoned, date of last production 19

Was permission obtained from the Conservation Division or its agents before plugging was commenced? Yes

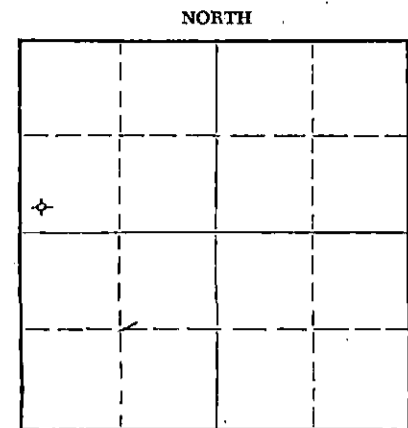

Locate well correctly on above Section Plat

Name of Conservation Agent who supervised plugging of this well M. A. Rives

Producing formation _____ Depth to top _____ Bottom _____ Total Depth of Well 4876 Feet

Show depth and thickness of all water, oil and gas formations.

OIL, GAS OR WATER RECORDS

CASING RECORD

FORMATION	CONTENT	FROM	TO	SIZE	PUT IN	PULLED OUT
		0	258'	8-5/8"	258'	none

Describe in detail the manner in which the well was plugged, indicating where the mud fluid was placed and the method or methods used in introducing it into the hole. If cement or other plugs were used, state the character of same and depth placed, from _____ feet to _____ feet for each plug set.

1/4 sack hulls and 20 sacks cement on bottom. Plug at 250'.
1/4 sack hulls and 10 sacks cement on top. Plug at 40'.
Cement mixed and poured through pipe. Filled with mud to surface.

REC'D
STATE CORP. COM.

10-12-54

(If additional description is necessary, use BACK of this sheet)

Name of Plugging Contractor Birmingham-Bartlett Drilling Co.

Address 300 Kaufman Building, Wichita 2, Kansas

STATE OF Kansas, COUNTY OF Sedgwick

Richard Hindery, partner of Birmingham-Bartlett Drilling Co., contractor of the above-described well, being first duly sworn on oath, says: That I have knowledge of the facts, statements, and matters herein contained and the log of the above-described well as filed and that the same are true and correct. So help me God. BIRMINGHAM-BARTLETT DRILLING CO.

(Signature) BY Richard Hindery
300 Kaufman Building, Wichita 2, Kansas

(Address)

SUBSCRIBED AND SWORN to before me this 29th day of September, 19 54

My commission expires October 2, 1954

Beverly Larson

Notary Public.

PLUGGING
FILE SEC 9 T 25 R 17W
BOOK PAGE 62 LINE 29

BRITTON NO. 1 WELL

LOCATION: SW/4 SW/4 NW/4
Section 9-258-17W
Edwards County, Kansas

SPUDED: 9-9-54
COMPLETED: 9-28-54

OWNER: Twin Oil Corporation
2706 Republic National Bank Building
Dallas, Texas

CONTRACTOR: Birmingham-Bartlett Drilling Co.
300 Kaufman Building
Wichita 2, Kansas

SURFACE CASING: 8-5/8" casing cemented at 258'
with 175 sacks cement and 2 cc.

OIL STRING: None set. Dry and abandoned.

LOG

(Figures indicate bottom of formation)

0	70	Sand
	263	Sand and shale
	500	Sand and red bed
	1840	Shale and shells
	1865	Anhydrite
	2295	Shale and shells
	2510	Broken lime
	2845	Shale and lime
	3375	Shale and shells
	3475	Lime and shale
	3550	Lime
	3705	Lime and shale
	3755	Lime
	3928	Shale and lime
	3935	Broken lime
	3941	Shale
	4435	Lime
	4444	Cherty lime
	4465	Chert and lime
	4480	Shale
	4508	Sand
	4530	Shale, sand and chert
	4700	Shale and chert
	4730	Lime and chert
	4840	Lime and shale
	4876	Lime
	4876	RTD - D & A

RECEIVED
CORPORATION COMMISSION

SEP 12 1954

CONSERVATION DIVISION

The undersigned, Richard Hindery, one of the partners of Birmingham-Bartlett Drilling Co., hereby certifies that the above is a true and correct log of the formations encountered in drilling the Britton No. 1 Well as shown in the daily drilling reports.

BIRMINGHAM-BARTLETT DRILLING CO.

By Richard Hindery

Subscribed and sworn to before me
this 29th day of September, 1954.

Beverly Larson

Notary Public

commission expires

October 2, 1954

PLUGGING

FILE SEC 9 Y 25 R 174
BOOK PAGE 67 LINE 29