


STATE OF KANSAS  
STATE CORPORATION COMMISSION

Form CP-4

Give All Information Completely  
Make Required Affidavit  
Mail or Deliver Report to:  
Conservation Division  
State Corporation Commission  
212 No. Market  
Wichita, Kansas 67202

WELL PLUGGING RECORD

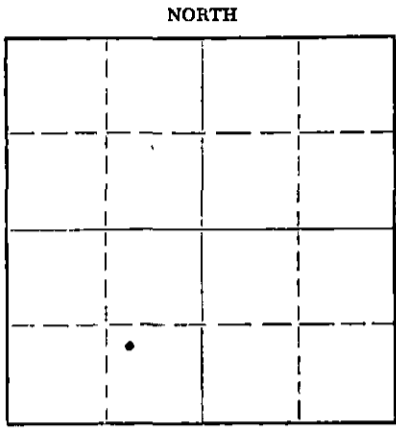

Locate well correctly on above Section Plat

Edwards County. Sec. 9 Twp. 25 Rge. (E) 17 (W)  
Location as "NE/CNWxSWx" or footage from lines NW SE SW  
Lease Owner The Bovaird Supply Company  
Lease Name Sibley Well No. 1  
Office Address P.O. Box 2590, Tulsa, Oklahoma  
Character of Well (completed as Oil, Gas or Dry Hole) oil  
Date well completed 19  
Application for plugging filed January 6 1970  
Application for plugging approved 19  
Plugging commenced January 10 1970  
Plugging completed January 15 1970  
Reason for abandonment of well or producing formation depleted

If a producing well is abandoned, date of last production 19  
Was permission obtained from the Conservation Division or its agents before plugging was commenced? YES

Name of Conservation Agent who supervised plugging of this well Ralph Warren  
Producing formation Depth to top Bottom Total Depth of Well 4907 Feet  
Show depth and thickness of all water, oil and gas formations.

OIL, GAS OR WATER RECORDS

CASING RECORD

FORMATION	CONTENT	FROM	TO	SIZE	PUT IN	PULLED OUT
		0	495'	8 5/8"	495'	none
		0	4593'	5 1/2"	4593'	3019.65

Describe in detail the manner in which the well was plugged, indicating where the mud fluid was placed and the method or methods used in introducing it into the hole. If cement or other plugs were used, state the character of same and depth placed, from feet to feet for each plug set.

Sanded back to 4570' and dumped 5 sacks of cement.  
Squeezed well with 20 sacks mud and 100 sacks of cement.

RECEIVED  
STATE CORPORATION COMMISSION  
JAN 26 1970  
CONSERVATION DIVISION  
Wichita, Kansas  
1-26-70

(If additional description is necessary, use BACK of this sheet)  
Name of Plugging Contractor PIPE PULLERS, INC.  
Address Box 486, Ellinwood, Kansas

STATE OF Kansas, COUNTY OF Barton, ss.  
Evelyn Roth (employee of owner) or (owner or operator) of the above-described

well, being first duly sworn on oath, says: That I have knowledge of the facts, statements, and matters herein contained and the log of the above-described well as filed and that the same are true and correct. So help me God.

(Signature) Evelyn Roth  
Ellinwood, Kansas (Address)

SUBSCRIBED AND SWORN TO before me this 23 day of January, 1970

George A. Meyer  
Notary Public.

My commission expires Feb. 10, 1971

DRILLER'S LOG

SIBLEY #1

COMPANY: WESTERN PETROLEUM CO., INC.  
 CONTRACTOR: WESTERN PETROLEUM CO., INC.  
 WASHDOWN COMMENCED: FEBRUARY 13, 1964  
 WASHDOWN COMPLETED: FEBRUARY 18, 1964  
 LOCATION: NW SE SW  
 SECTION 9-T253-N17W  
 EDWARDS COUNTY, KANSAS  
 ELEVATION: 2136 MB  
 CASING: 144 JTB. 5 1/2" 14# CASING.  
 SET @ 4593' W/250 SXS.

RECEIVED  
 STATE CORPORATION COMMISSION  
 JAN 7 1970  
 CONSERVATION DIVISION  
 Wichita, Kansas

WELL WAS WASHED DOWN TO TOTAL DEPTH OF 4307'.  
 ORIGINAL WELL DRILLED BY STENGLING OIL & GAS COMPANY.  
 COMPLETED: JULY 28, 1950  
 OLD TOTAL DEPTH: 4095'  
 NO NEW FORMATIONS PENETRATED.  
 DST #1 4447-4468'. PRELIMINARY OPEN 30". GAS TO SURFACE  
 34". INITIAL SHUT IN 30". OPEN 1 HR. GAS LEVELED OFF  
 @ 2,250 NEF IN 20". FINAL SHUT IN 45". ISIP 1410#/30",  
 FOMP 1365#/45", FP 390#. RECOVERED 25' GAS CUT MUD.  
 MH 2460#.

DST #2 4095.5-4098' (MC). OPEN 90 MINS. RECOVERED 11,000 CC  
 FILTRATE WATER. ISIP 1500 PSI/12", SAMPLING PRESSURE LESS THAN  
 50 PSI, FSIP 1500 PSI/15".

ELECTRIC LOG TOPS:	ANHYDRITE	1167	/ 969
	HEEREN	3808	-1672
	LANSING	3952	-1816
	B/MC	4252	-2116
	MISS.	4442	-2306
	KINDERHOOK	4476	-2340
	VIOLE	4541	-2618
	ARBUCKLE	4626	-2710

STATE OF KANSAS }  
 COUNTY OF BARTON } SS

I, THE UNDERSIGNED, BEING DULY SWORN ON OATH, STATE THAT THE  
 ABOVE STATEMENT AND LOG ARE TRUE AND A CORRECT RECORD AND LOG  
 OF THE WELL WASHED DOWN AT THE LOCATION ABOVE DESCRIBED.

WESTERN PETROLEUM CO., INC.

*F. L. Copeland*  
 F. L. COPELAND, DRILLING SUPT.

SUBSCRIBED AND SWORN TO BEFORE ME THIS 20TH DAY OF FEBRUARY, 1964.

*Neva C. Brown*  
 NEVA C. BROWN, NOTARY PUBLIC

MY COMMISSION EXPIRES JANUARY 15, 1967.