


WELL PLUGGING RECORD

Give All Information Completely  
Make Required Affidavit  
Mail or Deliver Report to:  
Conservation Division  
State Corporation Commission  
211 North Broadway  
Wichita, Kansas

NORTH

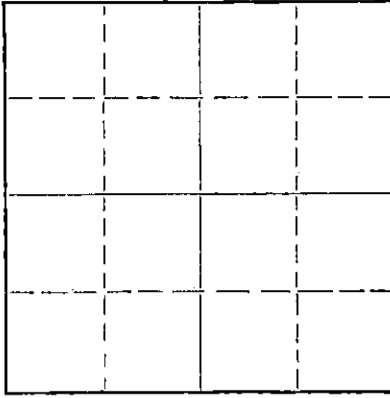

Locate well correctly on above  
Section Plat

Edwards County. Sec. 11 Twp. 25 Rge. 17 (E) W (W)  
Location as "NE/CNW/SW" or footage from lines C NW SW  
Lease Owner Honaker-Davis Drlg. Co.  
Lease Name Tubbs Well No. 1  
Office Address 2008 Lakin, Great Bend, Kansas  
Character of Well (completed as Oil, Gas or Dry Hole) Dry Hole  
Date well completed 5-18 1959  
Application for plugging filed 5-18 1959  
Application for plugging approved 5-18 1959  
Plugging commenced 9:00 a.m. 5-18 1959  
Plugging completed 12:00 noon 5-18 1959  
Reason for abandonment of well or producing formation \_\_\_\_\_

If a producing well is abandoned, date of last production \_\_\_\_\_ 19\_\_\_\_  
Was permission obtained from the Conservation Division or its agents before plugging was commenced? yes

Name of Conservation Agent who supervised plugging of this well Frank Broadfoot  
Producing formation \_\_\_\_\_ Depth to top \_\_\_\_\_ Bottom \_\_\_\_\_ Total Depth of Well 4605 Feet  
Show depth and thickness of all water, oil and gas formations.

OIL, GAS OR WATER RECORDS

CASING RECORD

FORMATION	CONTENT	FROM	TO	SIZE	PUT IN	PULLED OUT
				8 5/8"	242	None

Describe in detail the manner in which the well was plugged, indicating where the mud fluid was placed and the method or methods used in introducing it into the hole. If cement or other plugs were used, state the character of same and depth placed, from \_\_\_\_\_ feet to \_\_\_\_\_ feet for each plug set.

Filled hole with heavy rotary mud to 225'. Set plug. Dumped in 1/2 sack hulls. Mixed 20 sacks cement by hand. Poured same through drill pipe.

Filled hole with heavy rotary mud to 35'. Set plug. Dumped in 1/2 sack hulls. Mixed 10 sacks of cement by hand. Poured same in hole which filled hole to bottom of cellar.

RECEIVED  
STATE CORPORATION COMMISSION  
MAY 20 1959  
5-20-59  
CONSERVATION DIVISION  
Wichita, Kansas

(If additional description is necessary, use BACK of this sheet)

Name of Plugging Contractor \_\_\_\_\_  
Address \_\_\_\_\_

STATE OF Kansas, COUNTY OF Barton, ss.  
S. C. Lingreen (employee of owner) or (owner or operator) of the above-described well, being first duly sworn on oath, says: That I have knowledge of the facts, statements, and matters herein contained and the log of the above-described well as filed and that the same are true and correct. So help me God.

(Signature) S. C. Lingreen  
Great Bend, Kansas (Address)

SUBSCRIBED AND SWORN TO before me this 19th day of May, 19 59

My commission expires 6-25-59  
Kenneth G. Fischer Notary Public.

PLUGGING  
FILE SEC 11 T 25 R 12 W  
BOOK PAGE 40 LINE 3

DRILLERS' LOG

Tubbs No. 1  
Loc: C NW SW  
Sec: 11-25S-17W  
Edwards County, Kansas  
Company: Honaker-Davis Drlg. Co., et al  
Contractor: Honaker-Davis Drlg. Co.

Comm: 5-7-59  
Comp: 5-18-59  
Rotary Total Depth: 4605'  
Casing: 8 5/8" at 242'  
D & A

0	30	Top soil & clay
30	155	Sand & Gravel
155	242	Blue Shale
242	1129	Shale & Red Bed
1129	1154	Anhydrite
1154	1525	Shale & Shells
1525	1830	Lime & Shale
1830	2000	Shale & Shells
2000	2130	Shale & Lime
2130	2940	Lime & Shale
2940	2985	Shale
2985	4385	Lime & Shale
4385	4455	Lime, Shale & Chert
4455	4605	Lime & Chert
4605		Total Rotary Depth

8 5/8" casing cemented at 242' with 200 sacks cement and 3% calcium chloride.

RECEIVED  
STATE COMMISSION  
CONSERVATION DIVISION  
Wichita, Kansas


MAY 20 1959

D & A

I certify that this is the true and correct copy of the above log to the best of my knowledge.

  
H. S. Forbes

Subscribed and sworn to before me this 19th day of May, 1959.

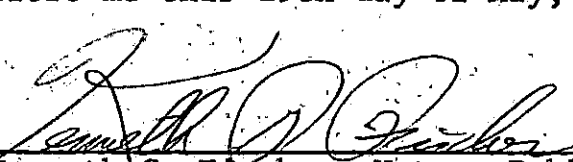  
Kenneth G. Fischer, Notary Public

My commission expires: 6-25-59

PLUGGING  
FILE: SEC. 11 T25 R. 12W  
BOOK PAGE 40 LINE 9