


STATE OF KANSAS
STATE CORPORATION COMMISSION

15-185-00874-0001

WELL PLUGGING RECORD

Give All Information Completely
Make Required Affidavit
Mail or Deliver Report to
Conservation Division
State Corporation Comm.
245 North Water
Wichita, KS 67202

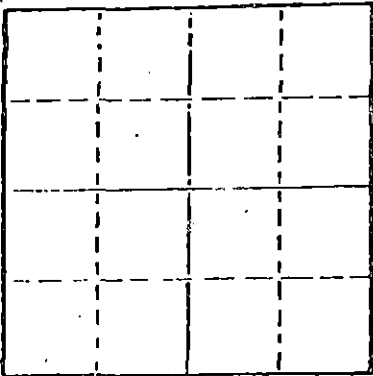

Locate well correctly on above
Section Plat

Stafford County. Sec. 15 Twp. 25 Rge. 12E/W
Location as "NE/CNW1SW1" or footage from lines
NE NE NE
Lease Owner Kelso Casing Pulling
Lease Name Reiter Gray #1 Well No.
Office Address Chase, Kansas 67524
Character of Well (Completed as Oil, Gas or Dry Hole)

Date Well completed 19
Application for plugging filed 19
Application for plugging approved 19
Plugging commenced 12/15/78 19
Plugging completed 12/18/78 19
Reason for abandonment of well or producing formation
depleted
If a producing well is abandoned, date of last production 19

Was permission obtained from the Conservation Division or
its agents before plugging was commenced? yes

Name of Conservation Agent who supervised plugging of this well Owens
Producing formation Depth to top Bottom Total Depth of Well 4090
Show depth and thickness of all water, oil and gas formations.

OIL, GAS OR WATER RECORDS


CASING RECORD

FORMATION	CONTENT	FROM	TO	SIZE	PUT IN	PULLED OUT
				8-5/8	300	none
				5 1/2"	4090	2899

Describe in detail the manner in which the well was plugged, indicating where the mud fluid
was placed and the method or methods used in introducing it into the hold. If cement or other
plugs were used, state the character of same and depth placed, from feet to
feet for each plug set.

Pushed wood plug to 3200', sanded to 3175' and ran 5 sacks cement.
Shot pipe at 2901', pulled 92 joints. Allied pumped 3 sacks hulls,
20 sacks gel, 2 sacks hulls, plug and 100 sacks pos, 2% gel and 3% cc.

PLUGGING COMPLETE.

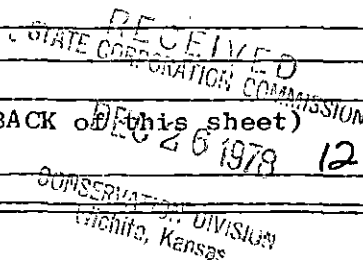

(If additional description is necessary, use BACK of this sheet)


Name of Plugging Contractor KELSO CASING PULLING
CHASE, KANSAS

STATE OF KANSAS COUNTY OF RICE
R. DARRELL KELSO (employee of owner) or (owner or operator)
of the above-described well, being first duly sworn on oath, says: That I have knowledge of
the facts, statements, and matters herein contained and the log of the above-described well
as filed and that the same are true and correct. So help me God.

(Signature) [Signature]
Chase, Kansas
(Address)

SUBSCRIBED AND SWORN TO before me this 22nd day of Dec., 19 78

My commission expires

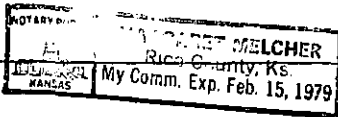

[Signature]
Notary Public.