


STATE OF KANSAS
STATE CORPORATION COMMISSION

Give All Information Completely
Make Required Affidavit
Mail or Deliver Report to:
Conservation Division
State Corporation Commission
800 Bittig Building
Wichita, Kansas

15-185-00874-0000
WELL PLUGGING RECORD

NORTH

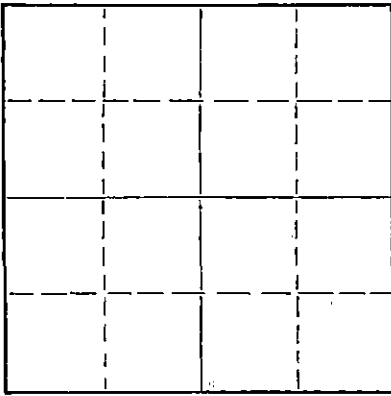

Locate well correctly on above
Section Plat

Stafford County. Sec. 15 Twp. 25S Rge. 12 (E) (W)
Location as "NE/CNW/SW" or footage from lines NE NE NE
Lease Owner National Cooperative Refinery Association
Lease Name Jenkins Well No. 1
Office Address 305 Rule Building, Wichita, Kansas
Character of Well (completed as Oil, Gas or Dry Hole) Dry Hole
Date well completed November 14, 1954
Application for plugging filed November 16, 1954
Application for plugging approved November 17, 1954
Plugging commenced November 14, 1954
Plugging completed November 14, 1954
Reason for abandonment of well or producing formation Dry Hole

If a producing well is abandoned, date of last production _____ 19____
Was permission obtained from the Conservation Division or its agents before plugging was commenced? Yes

Name of Conservation Agent who supervised plugging of this well Warren Horner
Producing formation _____ Depth to top _____ Bottom _____ Total Depth of Well 4225 Feet
Show depth and thickness of all water, oil and gas formations.

OIL, GAS OR WATER RECORDS

CASING RECORD

FORMATION	CONTENT	FROM	TO	SIZE	PUT IN	PULLED OUT
				8 5/8"	256'	None-cemented

Describe in detail the manner in which the well was plugged, indicating where the mud fluid was placed and the method or methods used in introducing it into the hole. If cement or other plugs were used, state the character of same and depth placed, from _____ feet to _____ feet for each plug set.

Mudded hole to 250'. Dumped 1/3 sax hulls plus 10 sax cement thru drilling pipe.
Mudded hole to 25' dumped 1/3 sax hulls plus 10 sax of cement on up to base of cellar.

(If additional description is necessary, use BACK of this sheet)

Name of Plugging Contractor Garvey Drilling Company
Address 305 East Third Street, Wichita, Kansas

STATE OF Kansas, COUNTY OF Sedgwick, ss.
C. R. Sears (employee of owner) or (owner or operator) of the above-described

well, being first duly sworn on oath, says: That I have knowledge of the facts, statements, and matters herein contained and the log of the above-described well as filed and that the same are true and correct. So help me God.

(Signature) C.R. Sears

305 Rule Building, Wichita, Kansas
(Address)

SUBSCRIBED AND SWORN TO before me this 19th day of November, 19 54

My commission expires June 30, 1958

C. Orville May
Notary Public.

PLUGGING
FILE SEC 15-25-R-12W
BOOK PAGE 28 LINE 20

11-22-54

WELL LOG

15-185-00874-0000

COMPANY National Cooperative Refinery Assn.

SEC. 15 T. 25 R. 12

FARM JENKINS

NO. 1

LOC. NE NE NE


TOTAL DEPTH 4225

COUNTY Stafford County, Kansas

COMM. November 1, 1954

COMP. November 14, 1954

CONTRACTOR Garvey Drilling Company

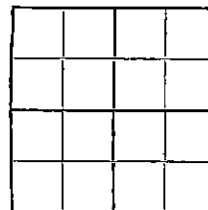

CASING 8-5/8" @ 256' w/200 sax.

ELEVATION

PRODUCTION D & A

FIGURES INDICATE BOTTOM OF FORMATIONS

120	Surface Sand
663	Red Bed
685	Anhydrite
1545	Shale & Shells
3521	Lime & Shale
3851	Lime
3880	Chert & Lime
3935	Chert
3968	Shale
4098	Chert
4176	Shale
4225	Lime
4225	T.D.

State of KANSAS
County of SEDGWICK

ss:

12-2-54

I, Karl E. Becker of Garvey Drilling Company

upon oath state that the above and foregoing is a true and correct copy of the log of the JENKINS #1 well.

Karl E. Becker

Subscribed and sworn to before me this 26th day of November, 19 54

My Commission Expires: 8-11-58

PLUGGING
FILE SEC 15 T. 25 R. 12
BOOK PAGE 28 LINE 20

John M. DeWard
NOTARY PUBLIC