


STATE OF KANSAS
STATE CORPORATION COMMISSION

Give All Information Completely
Make Required Affidavit
Mail or Deliver Report to:
Conservation Division
State Corporation Commission
211 No. Broadway
Wichita, Kansas

15-185-00518-0000
WELL PLUGGING RECORD

NORTH

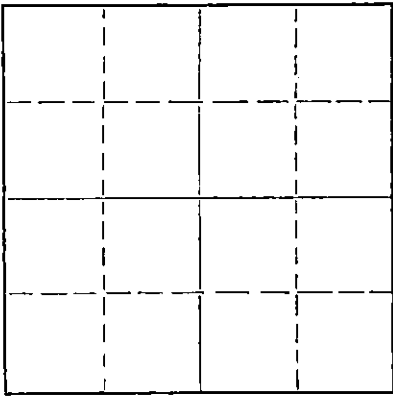

Locate well correctly on above
Section Plat

Stafford County, Sec. 4 Twp. 25 Rge. 12 (E) (W)
Location as "NE/CNW/SW" or footage from lines SE SE NW
Lease Owner Chief - Appleman - Aurora
Lease Name Mc Cune Well No. 1
Office Address Box 97, Great Bend, Kansas
Character of Well (completed as Oil, Gas or Dry Hole) Dry Hole
Date well completed 4-29-58 19
Application for plugging filed 4-29-58 19
Application for plugging approved 19
Plugging commenced 4-29-58 19
Plugging completed 4-29-58 19
Reason for abandonment of well or producing formation Dry Hole

If a producing well is abandoned, date of last production 19
Was permission obtained from the Conservation Division or its agents before plugging was commenced? Yes

Name of Conservation Agent who supervised plugging of this well John Broadfoot, St John, Kansas
Producing formation Depth to top Bottom Total Depth of Well 4200' Feet
Show depth and thickness of all water, oil and gas formations.

OIL, GAS OR WATER RECORDS

CASING RECORD

FORMATION	CONTENT	FROM	TO	SIZE	PUT IN	PULLED OUT
				8 5/8" 255'	255'	None

Describe in detail the manner in which the well was plugged, indicating where the mud fluid was placed and the method or methods used in introducing it into the hole. If cement or other plugs were used, state the character of same and depth placed, from feet to feet for each plug set.

1/2 Sack Halls, wooden plug @ 210', mixed 20 sacks cement through drill pipe.
1/2 Sack Halls, wooden plug @ 35', Mixed 10 sacks cement through drill pipe.

(If additional description is necessary, use BACK of this sheet)

Name of Plugging Contractor Chief Drilling Co., Inc.
Address Box 97, Great Bend, Kansas

STATE OF Kansas, COUNTY OF Barton, ss.
V. Richard Hoover (employee of owner) or (owner or operator) of the above-described well, being first duly sworn on oath, says: That I have knowledge of the facts, statements, and matters herein contained and the log of the above-described well as filed and that the same are true and correct. So help me God.

(Signature) V. Richard Hoover
Box 97, Great Bend, Kansas
(Address)

SUBSCRIBED AND SWORN TO before me this 30th day of April, 1958

My commission expires 12-14-61

Notary Public.

5-1-58
PLUGGING
FILE SEC 4 T. 25 R. 12 W
BOOK PAGE 97 LINE 17

15-185-00518-0000

WELL LOG

No. 1 McCune

Chief Drilling Co. - Appleman - Aurora
Box 97
Great Bend, Kansas

Elevation: 1895 DF
1893 GRD
1898 KB

Commenced: 4-18-58
Completed: 4-29-58

No. 1 McCune

SE SE NW Sec. 4 - 25 - 12W
Stafford County, Kansas

Contractor: Chief Drilling Co., Inc.
Rotary: 0 - 4200'

Casing Record: Set 255' of 8 5/8", 28# used casing W/250 sacks Pozmix, Cement the surface.

Figures Indicate Bottoms of Formation

Sand & Clay	0 - 255
Shale	255 - 410
Shale & Red Bed	410 - 710
Anhydrite	710 - 730
Shale & Shells	730 - 1370
Shale & Lime	1370 - 3295
Lime	3295 - 3860
Shale & Lime	3860 - 3932
Conglomerate	3932 - 3974
Chert & Lime	3974 - 4095
Shale	4095 - 4164
Dolomite	4164 - 4200

Formation Tops & Minus

Anhydrite	710 (+1188)
Heebner	3398 (-1500)
Brown Lime	3552 (-1654)
Lansing	3574 (-1676)
Base K. C.	3860 (-1962)
Conglomerate	3932 (-2034)
Viola	3974 (-2076)
Simpson	4095 (-2197)
Arbuckle	4164 (-2166)

State of Kansas)
County of Barton)

I hereby certify that the above is a true and correct copy of Drillers's Log of well drilled in the SE SE NW Sec. 4-25-12W, Stafford County, Kansas, to the best of my knowledge and belief.

CHIEF DRILLING CO., INC.

V. Richard Hoover
V. Richard Hoover, President

Subscribed to and sworn to before me this 30th day of Apr, 1958

J. P. Kramers
Notary Public

My Commission expires:

12-14-61

PLUGGING
FILE SEC. 4 T. 25 R. 12W
BOOK PAGE 97 LINE 17

RECEIVED
MAY 5-1-58
1958

CON. WICHITA, KANSAS